Form 51—5M—11-38—Palace


Barton

KANSAS

Section 16 Township 16 Range 12-W

Well No. ~~2~~ Kultgen #1

Company ~~Polk & Fortson~~ J.P. Taylor

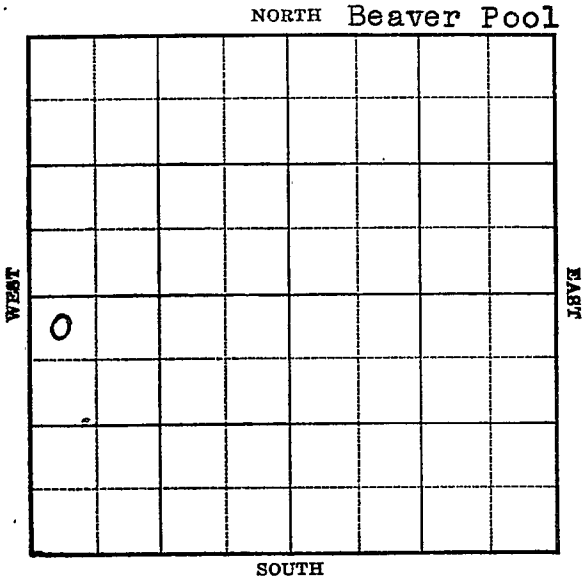

FORM 252-A 5M 10-38 KANSAS Barton

Sec. 16 Twp. 16 R. 12-W

Well No. ~~#2~~ Kultgen #1 Farm

~~Polk & Fortson~~ J.P. Taylor Company

(Beaver)


330 Ft. from N. Line

_____ Ft. from S. Line

_____ Ft. from E. Line

330 Ft. from W. Line

Elev. 1909

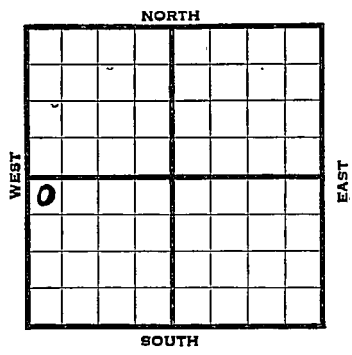

1939	REPORT
3/1	Cellar.
3/10	B.C.R.
3/17	R. U.
3/24	"
3/31	"
4/7	Spud.
4/14	15" - 91' 12" - 430'
	Drlg. 685'
4/21	Anhy 813' 10" - 820'
	Drlg. 1595'
4/28	8" - 2120' Drlg. 2220'
5/5	Drlg. 2520'
5/12	Lansing 3073' S.O. 3082-95'
	Drlg. 3150'
5/19	7" - 3183' WOC.
5/26	Gorham sand 3363' T.D. 3364' ~~SX~~
	S. O.
6/1	Shut down.
6/8	198'-5" liner 3364 WOC

OVER

1939

6/16 Oil 3369-72' T.D. 900' oil 6 hours. Swabbing 13 bbls. oil & 4 bbls. water per hour.

6/23 Shut down.

6/29 " "

7/6 " "

7/12 Gorham 3363'
T.D. 3373'

ABANDONED

Form 26—1M Bks.—2-29

Barton KANSAS

Map No. 55 Sec. 16 Twp. 16 R. 12W

Well No. 2 Kultgen

Polk & Fortson Company

Contractor

FIRST REPORT

NW SW

330 Ft. from N. Line


_____ Ft. from S. Line

_____ Ft. from E. Line

330 Ft. from W. Line

BEAVER POOL

SECTION PLAT

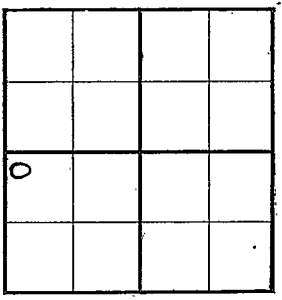

Location _____

Rig up _____

Drilling and Remarks:

Cellar

RECORD

Cased _____ in., _____ ft.

Sand _____

Gas _____

Oil _____

Total Depth _____

PRODUCTION

1st 24 hrs. Nat. _____

1st 24 hrs. after shot _____

Gas _____ Cu. Ft.

Dry Hole _____

Abandoned _____

Date

MAR 1 - 1939 19____ H. D. Hatfield Scout

Form 26—1M Bks.—2-29 Barton KANSAS

Map No. 55 Sec. 16 Twp. 16 R. 12 W

Well No. 1-Kultgen

J. P. Taylor Company

Contractor

NW SW

CORRECTION

330 Ft. from N. Line


Ft. from S. Line

Ft. from E. Line

330 Ft. from W. Line

CORRECTION

SECTION PLAT

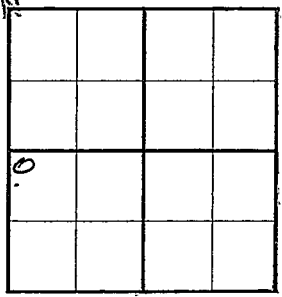

Location

Rig up

Drilling and Remarks:

1st reported as Polk & Fortson #2-Kultgen changed To J. P. Taylor #1-Kultgen

RECORD

Cased in., ft.

Sand

Gas

Oil

Total Depth

PRODUCTION

1st 24 hrs. Nat.

1st 24 hrs. after shot

Gas Cu. Ft.

Dry Hole

Abandoned

Date

APR 26 1939 19

E. D. Hatfield Scout

Form 26—1M Bks.—2-29 Barton KANSAS

Map No. 55 Sec. 16 Twp. 16 R. 12W

Well No. 1 Kultgen

James P. Taylor Company

Contractor

ABANDONED

NW SW

330 Ft. from N. Line


Ft. from S. Line

Ft. from E. Line

330 Ft. from W. Line

BEAVER POOL

SECTION PLAT

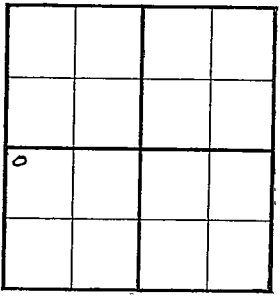

Location

Rig up

Drilling and Remarks:

Gorham-3363

RECORD

Cased in., ft.

Sand

Gas

Oil

Total Depth 3373

PRODUCTION

1st 24 hrs. Nat.

1st 24 hrs. after shot

Gas Cu. Ft.

Dry Hole

Abandoned

Date

JUL 12 1939 19

S. J. LEWIS Scout