

Section 5 Township 18 Range 1WWell No. #1 MessingerCompany Mallard Drlg.

NORTH

5

	0						

SOUTH

WEST

EAST

McPherson KANSAS

Sec. 5 Twp. 18 R. 1W

Well No. #1 Messinger Farm

Mallard

Company

Contractor

Padden


Ft. from N. Line

990' Ft. from S. Line

Ft. from E. Line

990' Ft. from W. Line

NE SW NW

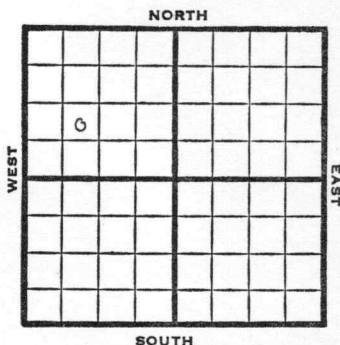

1950

Elev 1372

REPORT

8/30

Location

9/13

Spud 9-1-50

8 5/8" @ 130

Miss 2753

TD 2783

D&A

ABANDONED

County McPherson State Kansas

Sec. 5 (Blk. Twp.) 18 (Sur. Rge.) 1W Map No.

Operator Mallard Drlg.

Well No. 1 Farm Messinger

Elev.	Location	NE SW NW
-------	----------	-----------------

990 Ft. From S Line NW

990 Ft. From W Line Quarter

1st. Report **AUG 30 1950**

Completion


Remarks

Spudding Date _____

Drlg. Data

Location

J. E. TYRA

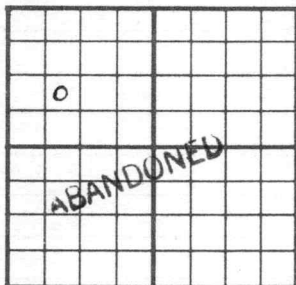County McPherson State KansasSec. 5 (^{Blk.}
Twp.) 18 (^{Sur.}
Rge.) 1W Map No.Operator Mallard Drlg.Well No. 1 Farm MessingerElev. 1372 Location NE SW NW990 Ft. From S Line NW990 Ft. From W Line Quarter1st. ReportCompletion SEP 13 1950RemarksPadden PoolSpudding Date 9-1-50Drlg. Data D & A TD 27838 5/8" @ 130 Miss. 2753 TD 2783D & A

J. E. TYRA