

Sec. 16 Twp. 16 R. 12W

Well No. #2 Jarus Farm

D. R. Lauck

Company

D. R. Lauck

Contractor

Kraft-Prusa Pool

Ft. from N. Line

330'


Ft. from S. Line

330'

Ft. from E. Line

Ft. from W. Line

SE NE

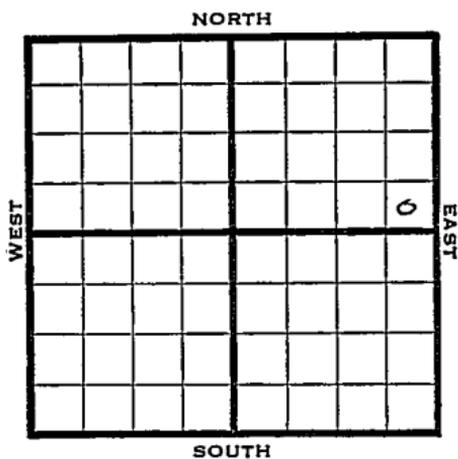

1949

Elev 1892'

REPORT

10/26

10" @ 285'
Drlg. 1685'

11/1

Lansing 3081'
Drlg. 3280'

11/9

TD 3397'
Arb. 3387'
Aband.

ABANDONED

Map No. _____ Sec. 16 Twp. 16 R. 12W

Well No. 2 Jarus

D. R. Lauck _____ Company

D. R. Lauck _____ Contractor

**FIRST REPORT
SECTION PLAT**

SE NE

			0

_____ Ft. from N. Line

330 Ft. from S. Line

330 Ft. from E. Line

_____ Ft. from W. Line

Barton County

Location _____

Rig up _____

Drilling and Remarks:

10" @ 285

drlg. 1685

RECORD

Cased _____ in., _____ ft.

Sand _____

Gas _____

Oil _____

Total Depth _____

PRODUCTION

1st 24 hrs. Nat. _____

1st 24 hrs. after shot _____

Gas _____ Cu. Ft.

Dry Hole _____

Abandoned _____

Date

OCT 26 1949

19

S. J. LEWIS

Scout

Kansas

Kraft-Prusa Pool

Map No. _____ Sec. 16 Twp. 16 R. 12W

Well No. 2 Jarus _____

D. R. Lauck _____ Company

ABANDONED

Contractor

SE NE

E. 1892
SECTION PLAT

_____ Ft. from N. Line

330 _____ Ft. from S. Line

330 _____ Ft. from E. Line

_____ Ft. from W. Line

Barton County

Location _____

Rig up _____

Drilling and Remarks:

Core 3387

RECORD

Cased _____ in., _____ ft.

Sand _____

Gas _____

Oil _____

Total Depth *3387* _____

PRODUCTION

1st 24 hrs. Nat. _____

1st 24 hrs. after shot _____

Gas _____ Cu. Ft.

Dry Hole _____

Abandoned _____

Date

NOV 9 1949 19

S. J. LEWIS Scout