

Section 25 Township 13 Range 17W

Well No. #1 Rome

Company Anschutz Drlg.

NORTH

							0

WEST

EAST

SOUTH

Ellis
13

KANSAS

Sec. 25 Twp. 13 R. 17W ✓

Well No. #1 Rome Farm

Anschutz Drlg. Company


Anschutz- Contr. Contractor

_____ Ft. from N. Line

330' Ft. from S. Line

330' Ft. from E. Line

_____ Ft. from W. Line

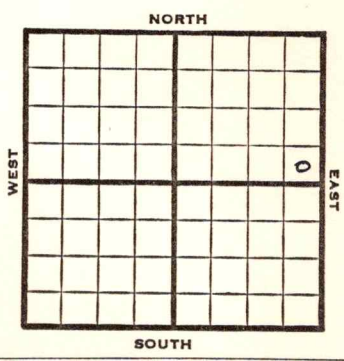

SE SE NE

1951 **Elev. 1963'** REPORT

1/24 Spud 1-22-51
8" @ 247'
WOC

2/7 Spud 1-22-51
D&A TD 3543'
8" @ 247' **Anhy 1115'**
Heeb. 3197' **Toronto 3222'**
Lans. 3245' **Con . 3494'**
TD 3543' D&A

ABANDONED


County Ellis State Kansas

Sec. 25 (Blk. Twp.) 13 (Sur. Rge.) 17W Map No.

Operator Anschutz Drlg.

Well No. 1 Farm Rome

Elev. _____ Location SE SE NE

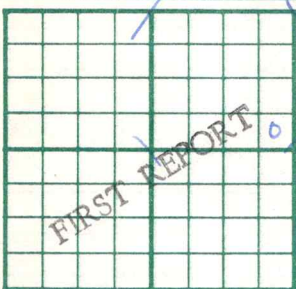

330 Ft. From S Line NE

330 Ft. From E Line Quarter

Ist. Report JAN 24 1951

Completion _____

Remarks _____

Anschutz - Contr.

Spudding Date 1-22-51

Drlg. Data _____

8" @ 247 WOC

J. E. TYRA

County Ellis State Kansas

Sec. 25 (Blk. 13) (Sur. 17W) (Twp.) (Rge.) Map No.

Operator Anschutz Drlg.

Well No. 1 Farm Rome

Elev. 1963 Location SE SE NE

330 Ft. From S Line NE
330 Ft. From E Line Quarter

1st. Report

Completion FEB 7 1951

Remarks

Anschutz Drlg. - Contr.

Spudding Date 1-22-51

Drlg. Data D & A TD 3543

8" @ 247 Anhy 1115 Heeb. 3197

Toronto 3222 Lans. 3245 Cong. 3494

TD 3543 D & A

J. E. TYRA