

DX 78-1

Cowley

O.W.W.O.

KANSAS

Section 19 Township 33 Range 3E

Well No. #1 Nelson

Company McNaish & Gralapp *Peak Mfg.*

NORTH *NE SE NE*

							o

WEST

EAST

SOUTH

Cowley

KANSAS

SEC.

19

2

TWP.

33

R.

3E

WELL NO.

1 Nelson

FARM

COMPANY

McNeish & Gralapp

CONTRACTOR

Watson

Rainbow Pool


_____ Ft. from N. Line

990' _____ Ft. from S. Line

330' _____ Ft. from E. Line

_____ Ft. from W. Line

NE SE NE

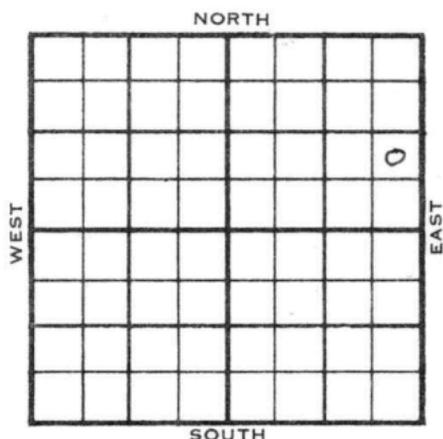

1955	ELEVATION REPORT																					
5/25	Setting Surface																					
6/15	Comm 5-29-55 8 5/8", @ 92/100 D&A																					
	<table border="0"> <thead> <tr> <th data-bbox="186 1193 497 1239">Tops</th> <th data-bbox="497 1193 745 1239">Depth</th> <th data-bbox="745 1193 1025 1239">Datum</th> </tr> </thead> <tbody> <tr> <td data-bbox="186 1239 497 1285">H. Stal</td> <td data-bbox="497 1239 745 1285">2244</td> <td data-bbox="745 1239 1025 1285">1075</td> </tr> <tr> <td data-bbox="186 1285 497 1331">Tr. Layton</td> <td data-bbox="497 1285 745 1331">2644</td> <td data-bbox="745 1285 1025 1331">1475</td> </tr> <tr> <td data-bbox="186 1331 497 1377">BKD Oswego</td> <td data-bbox="497 1331 745 1377">2997</td> <td data-bbox="745 1331 1025 1377">1828</td> </tr> <tr> <td data-bbox="186 1377 497 1423">Ce. Bart</td> <td data-bbox="497 1377 745 1423">3262</td> <td data-bbox="745 1377 1025 1423">2093</td> </tr> <tr> <td data-bbox="186 1423 497 1469">M. Ch.</td> <td data-bbox="497 1423 745 1469">3267</td> <td data-bbox="745 1423 1025 1469">2098</td> </tr> <tr> <td data-bbox="186 1469 497 1515">TD.</td> <td data-bbox="497 1469 745 1515">3272</td> <td data-bbox="745 1469 1025 1515"></td> </tr> </tbody> </table>	Tops	Depth	Datum	H. Stal	2244	1075	Tr. Layton	2644	1475	BKD Oswego	2997	1828	Ce. Bart	3262	2093	M. Ch.	3267	2098	TD.	3272	
Tops	Depth	Datum																				
H. Stal	2244	1075																				
Tr. Layton	2644	1475																				
BKD Oswego	2997	1828																				
Ce. Bart	3262	2093																				
M. Ch.	3267	2098																				
TD.	3272																					
	<p>ABANDONED</p>																					

County Cowley Elev. 1169
 Sec. 19 Twp. 33 Rge. 3E
 Company McNeish & Gralapp
 Farm Name Nelson No. 1

Co.

TOPS	DEPTH	LOG	DATUM
Anh.			
Tp.			
H. <u>Stal</u>	<u>2244</u>		<u>1075</u>
Tr. <u>Layton</u>	<u>2644</u>		<u>1475</u>
Dg.			
Bl.			
L.			
K.C.	<u>2809</u>		<u>1640</u>
B.K.C. <u>Oswego</u>	<u>2997</u>		<u>1828</u>
Ce. <u>Bartj</u>	<u>3262</u>		<u>2093</u>
C.			
M. <u>ch</u>	<u>3267</u>		<u>2098</u>
M.			
K.			
Mz.			
Me.			
V.			
S.			
S.			
A.			
R.			
PE.			
G.			
T.D.	<u>3272</u>		

Loc. in Sec. NE SE NE

Geol. _____
 Contr. Watson

~~Pool~~
Rainbow



ABANDONED

Use.

Date Comm. 5-29-55 JUN 15 1955
8 5/8" @ 92/100

D & A

No.

Sec.

T.

R.

Top N Foot Rainbow Bend

~~Co.~~ X Foot 25

O.W.W.O.

S-513-B

County Cowley Elev. _____
 Sec. 19 Twp. 33 Rge. 3E
 Company Peak Drlg.
 Farm Name Nelson No. 1

TOPS	DEPTH	LOG	DATUM
Anh.			
Tp.			
H.			
Tr.			
Dg.			
Ex Stal	2244		
x Lay	2634		
K.C.	2808		
XXXX Osw	2997		
xx Btvl	3262		
C.			
M.	3267		
M.			
K.			
Mz.			
Mq.			
V.			
S.			
S.			
A.			
R.			
Pf.			
G.			
T.D.	OTD	3272	

Loc. in Sec. _____
NE SE NE
(O.W.W.O.)
 Geol. J. Craig
 Contr. _____
Peak #14
 Pool _____
Rainbow Bend



Date Comm. _____
OLD INFO: Tops. was D & A oper was McNeish & Gralapp.
NEW INFO: MI & Washing Down.

Co.
Lse.
No.
Sec.
T.
R.

O.W.W.O.

~~Twp~~ Pool ~~Co.~~ Facet

S-513-B

County Cowley Elev. 1169 DF
Sec. 19 Twp. 33 Rge. 3E
Company Peak Drlg.
Farm Name Nelson No. 1

TOPS	DEPTH	LOG	DATUM
Anh.			
Tp.			
H.			
Tr.			
Dg.			
B Stal	2244		
x Lay	2634		
K.C.	2808		
xxxx Osw	2997		
xx Btvl	3262		
C.			
M.	3267		
M.			
K.			
Mz.			
Mq.			
V.			
S.			
S.			
A.			
R.			
Pf.			
G.			
T.D.	OTD	3272	

Loc. in Sec. NE SE NE
(O.W.W.O.)
O.W.W.O.
Geol. J. Craig
Contr. Peak #14
Pool Rainbow Bend

ABANDONED
APR 30 '58

Date Comm. OLD INFO: Tops. was D & A oper was McNeish & Gralapp.

NEW INFO: MI & Washing Down.
DD 3310 TD 5 1/2 3309/100 WOC
APR 2 '58 APR 9 '58 APR 10 '58 APR 23 '58 APR 30 '58

Pf/ 3262-65 frac 5/10 oil
D+A