


DX 78-1 Cowley

KANSAS
3E

Section 19 Township 33 Range 3E

Well No. #3 Nelson

Company McNeish

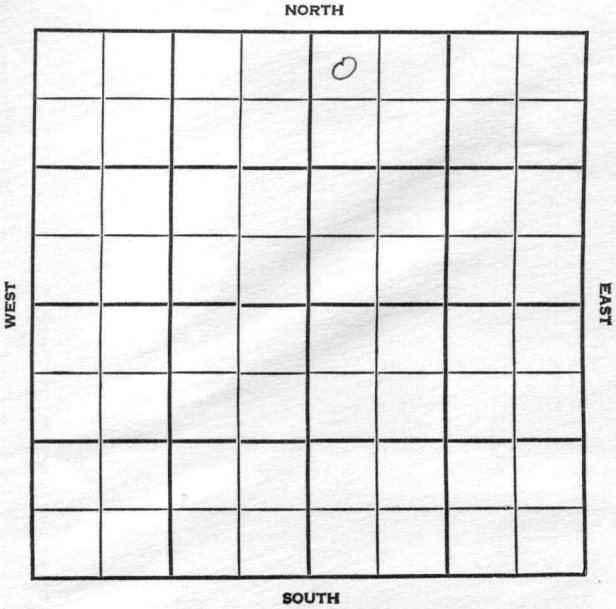

Cowley

KANSAS

SEC.

19

TWP.

33

R.

3E

WELL NO.

#3 Nelson

FARM

COMPANY

McNeish

CONTRACTOR


____ FT. FROM N. LINE

____ FT. FROM S. LINE

____ FT. FROM E. LINE

____ FT. FROM W. LINE

NW NW NE

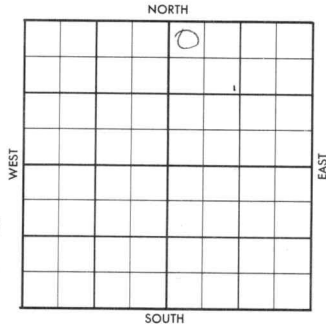

1956

ELEVATION

1131'

REPORT

7-3

Location

7-25

Comm. 7-3-56

8 5/8" @ 90 w/90

5 1/2" @ 3223

CO 3214 24/3206-12

P/ 25 BOPD, no/wtr.

Stall. 2220'; Lay. 2602'; KC 2767';

Osw. 2908'; Bartl. 3206';

TD 3227'

COMPLETED

29

County Cowley Elev. _____
 Sec. 19 Twp. 33 Rge. 3E
 Company McNeish
 Farm Name Nelson No. 3

TOPS	DEPTH	LOG	DATUM
------	-------	-----	-------

Anh.					NW NW NE
------	--	--	--	--	----------

T.p.				NW NW NE
------	--	--	--	----------

H.				
----	--	--	--	--

Tr.				
-----	--	--	--	--

Do			
----	--	--	--

R.I..				
-------	--	--	--	--

--	--	--	--

K.C.				Geol.
------	--	--	--	-------

BKC.			
------	--	--	--

Contr.			
--------	--	--	--

cc.			
C			

--	--	--	--	--

M.				
M.				

Pool				
------	--	--	--	--

MZ				
Mo				

MB.				
V				

[illegible][illegible]

S.				
A				

[illegible]

R.				FIRST REPORT
Bc				

Re.			FIRST	REF
6				

G.					
----	--	--	--	--	--

Geol.

Contr.

Pool

FIRST REPORT

JUL 3 '58

Date Comm.

Location

JUL 1 1958


County Coxley Elev. 1131
 Sec. 19 Twp. 33 Rge. 3E
 Company McLeish
 Farm Name Nelson No. 3

TOPS	DEPTH	LOG	DATUM	Loc. in Sec.
Anh.				NW NW NE
Tp. <u>Stall</u>	<u>2220</u>			
H. <u>Lay</u>	<u>2602</u>			
Tr.				
Dg.				
BL				
L.				
K.C.	<u>2767</u>			Geol.
Bkf. <u>OSW</u>	<u>2908</u>			Contr.
Gr. <u>Bartl</u>	<u>3206</u>			
C.				
M.				
M.				Pool
K.				
Mz.				
Mo.				
V.				
S.				
S.				
A.				
R.				
Pe.				
G.				
TD	<u>3227</u>			

COMPLETE

JUL 25 1956

Date Comm.

Location JUL 11 '56 7-3-56 85/8 90

190 1/2 3055 JUL 18 '56 5 1/2 @ 3223

JUL 25 '56 Co 3214 24/3206-12

550 FRAC P. 25 Bopd no/w