

Cowley

Map No. *Kansas* Sec. *21* Twp. *33* R. *3E*

Well No. *1 Hunt* Farm


Derby Oil Company

362 Ft. from N. Line

_____ Ft. from S. Line

2044 Ft. from E. Line

_____ Ft. from W. Line

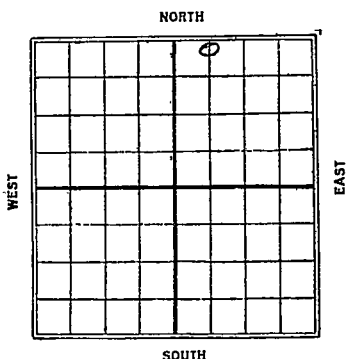

Date

REPORT

1925

<i>9/9</i>	<i>Rig</i>
<i>9/16</i>	<i>Spudding</i>
<i>9/24</i>	<i>Wdly @ 400'</i>
<i>9/30</i>	<i>" @ 900'</i>
<i>10/6</i>	<i>" @ 1300</i>
<i>12/16</i>	<i>Top sand 3217 T.D. 3240</i>
	<i>Shut 20 gts 3226-3237</i>
	<i>40 Bbls</i>

County *Rowley*
 Map No. **KANSAS** Sec. *21* Twp. *33* R. *3E*

Well No. *1 Hunt*

Herby Oil Company

Contractor

SECTION PLAT

362 Ft. from N. Line

_____ Ft. from S. Line

2044 Ft. from E. Line

_____ Ft. from W. Line

		0	

FIRST REPORT

Location _____

Rig up _____

Drilling and Remarks:

Rig

RECORD

Cased _____ in., _____ ft.

Sand _____

Gas _____

Oil _____

Total Depth _____

PRODUCTION

1st 24 hrs. Nat. _____

1st 24 hrs. after shot _____

Gas _____ Cu. Ft.

Dry Hole _____

Abandoned _____

Date

SEP 9 1923

S. J. LEWIS

Scout

Map No. KANSAS Sec. 21 Twp. 33 R. 24

Well No. 1 Hunt

Terby Oil Company

Contractor

SECTION PLAT

		0	

362 Ft. from N. Line

_____ Ft. from S. Line

2044 Ft. from E. Line

_____ Ft. from W. Line

COMPLETED

Location _____

Rig up _____

Drilling and Remarks:

TS 3217
TD 3240 in @ ka
Shot 20 gts
3226-3237
40 ft/l

RECORD

Cased _____ in., _____ ft.

Sand _____

Gas _____

Oil _____

Total Depth _____

PRODUCTION

1st 24 hrs. Nat. _____

1st 24 hrs. after shot _____

Gas _____ Cu. Ft.

Dry Hole _____

Abandoned _____

Date

DEC 16 1965

S. J. LEWIS

Scout