


Section 26 Township 13 Range 17W

Well No. #2 Braun

Company Leo J. Dreiling

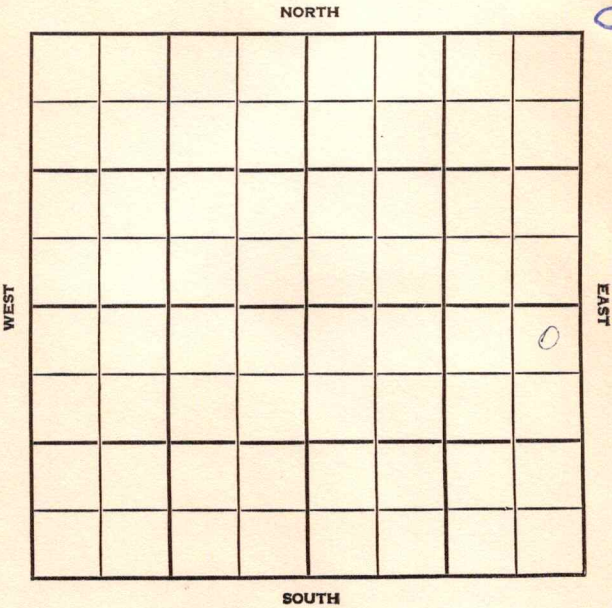

457155

County Ellis Elev. _____
 Sec. 26 Twp. 13 Rge. 17W
 Company Leo J. Dreiling
 Farm Name Braun No. 2

TOPS	DEPTH	LOG	DATUM	Loc. in Sec.
Anh.				NE NE SE
TP.				
H.				
Tr.				
Dg.				
Bl.				
L.				Geol.
K.C.				Contr.
B.K.C.				Garvey Tools
Ce.				Pool
C.				Sugarloaf SE
M.				
M.				
K.				
Mz.				
Ma.				
V.				
S.				
S.				
A.				
R.				
Pe.				
G.				
T.D.				

FIRST REPORT

Date Comm. spd. 11-2-56
8" @ 135, w/100, Drlg. 2245

NOV 5 1956

R.G.

Co.

Use.

No.

Sec.

T.

R.

County Ellis Elev. 1976 DP
 Sec. 26 Twp. 13 Rge. 17W
 Company Leo J. Dreiling
 Farm Name Braun No. 2

TOPS	DEPTH	LOG	DATUM	Loc. in Sec.
Anh.				NE NE SE
TP.	2970			
H.	3221			
Tr.	3243			
Dg.				
Bl.				
L.	3267			Geol.
K.C.				Contr.
B.K.C.				Garvey Tools
Ce.				# 8
C. cherty	3517			Pool
M.				Sugarloaf SE
M.				
K.				
Mz.				
Mq.				
V.				
S.				
S.				
A.				
R.				
Pe.				
G.				
RTD.	3550			

COMPLETE
 DEC 19 56

Date Comm. spd. 11-2-56

8" @ 135, w/100, Drlg. 2245 NOV 13 56 EL.

TP 2970 H6 3221 Tr 3243 Ls9 3267
 DST 3279-3312 op 1hr 420' 925
 nec 70' HOCM + 60' VHOCM + 60' MCO
 BHP 860/20" DST 3318-55 op 1hr
 nec 20' HOCM + 30' Md BHP 235/20"
 and ~~the~~ Building c9 chert 3517
 RTD 3550 in c9 chert 5 1/2 @ 3548
 1150 a.m.

NOV 21 56

Co. 20/3335-40 tst sso

NOV 28 '56 X \$ 5 Boph no wtr
 2 hrs 20/3291-96 Both PFS. total

3 Acid \$ 10 Boph no wtr 3 hrs
 set PKR 12 PFS 3291-96 \$

both PFS \$ 15 Boph no wtr 6 hrs
 POP. DEC 5 '56 V DEC 12 '56 Ph P 80

Boph no wtr grass 32°