

Cowley


KANSAS

SECTION 14 TOWNSHIP 33 RANGE 3 E

WELL NO. #1 Able

COMPANY Wakefield

NORTH

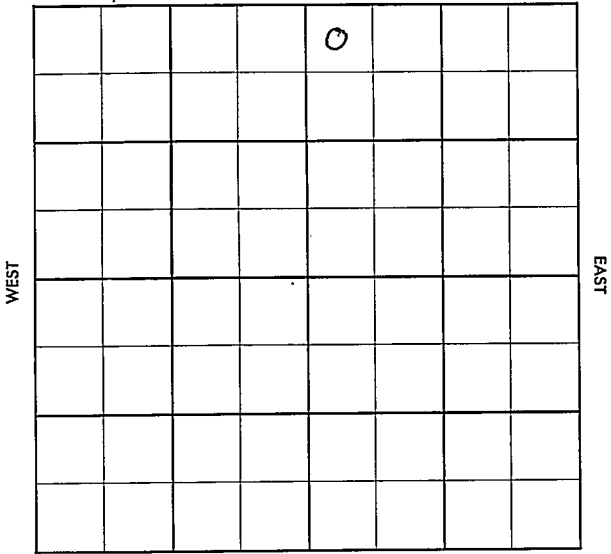

SOUTH

Cowley

KANSAS

SEC.

TWP.

R.

~~74~~ 14

33

3E

WELL NO.

#1 Able

FARM

COMPANY

Wakefield

CONTRACTOR

Co. Tools


WILDCAT

_____ Ft. from N. Line

_____ Ft. from S. Line

_____ Ft. from E. Line

_____ Ft. from W. Line

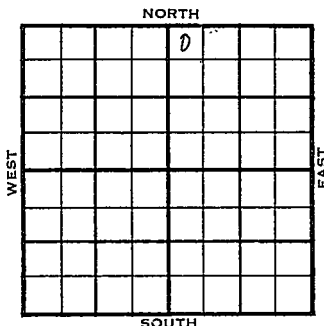

NW NW NE

SDE - 1/2 mile

1956	ELEVATION	REPORT
1956	1172 KB	REPORT
1-18	RUR	
1-25	Comm. 1-15-56 8 5/8" @ 100/80 D& A Layton 2627 KC 2809 Bart 3302 M. 3315 TD 3345	

ABANDONED

County Cowley Elev. _____
 Sec. 14 Twp. 33 Rge. 3E
 Company Wakefield
 FarmName Able No. 1

TOPS	DEPTH	LOG	DATUM
Anh.			
Tp.			
H.			
Tr.			
Dg.			
Bl.			
L.			
K.C.			
B.K.C.			
Ce.			
C.			
M.			
M.			
K.			
Mz.			
Mq.			
V.			
S.			
S.			
A.			
R.			
PE.			
G.			
T.D.			

Loc. in Sec. NW NW NE
 Geol. _____
 Contr. _____
 Co. tools _____
 Pool Wildcat

	0
	JAN 18 '60
FIRST REPORT	
1/2 mile	

Date Comm. RUR

Co.
Lse.
No.
Sec.
T.
R.

County Cowley Elev. 1172 KB
 Sec. 14 Twp. 33 Rge. 3E
 Company Wakefield
 Farm Name Able No. 1

TOPS	DEPTH	LOG	DATUM	Loc. in Sec.
Anh.				NW NW NE
TP.				
H. <u>Layton</u>	<u>2627</u>		<u>1455</u>	
Tr.				
Dg.				
Bl.				
L.				
K.C.	<u>2809</u>		<u>1637</u>	Geol.
B.K.C. <u>Bart.</u>	<u>3302</u>		<u>2130</u>	Contr.
Ce.				Co. tools
C.				
M.				Pool
M.	<u>3315</u>		<u>2143</u>	Wildcat
K.				
Mz.				
Me.				
V.				
S.				
S.				
A.				
R.				
PE.				
G.				
T.D.	<u>3345</u>			

Date Comm. 1-15-56

JAN 25 1956

8 5/8" @ 100/80

D & A

ABANDONED