

Section 26 Township 13 Range 17W

Well No. 1 Braun "B"

Company Elreco & Anschutz

NORTH

WEST

EAST

SOUTH

~~13~~
12

0



Sec. 26 Twp. 13 R. 17 W

Well No. # 1 Braun "B" Farm _____

Elreco & Anschutz Company _____

Anschutz Drlg. Contractor _____

Rome Drlg.


330 Ft. from N. Line

_____ Ft. from S. Line

_____ Ft. from E. Line

330 Ft. from W. Line

NW NW SW

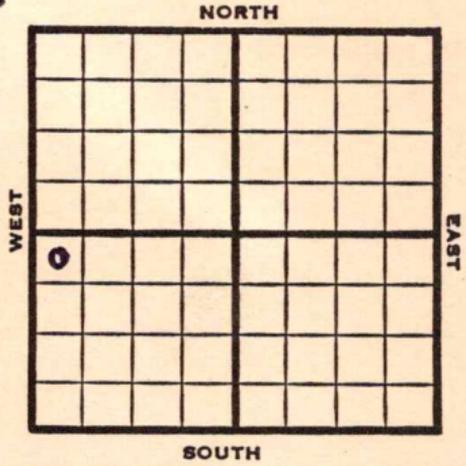

1952 **Elev. 1983'** REPORT

12/30 Spud 12-27-52
8" @ 321'

1/1 8" @ 321

1/8 Heeb 3219 Tor 3237 Lans 3264 Ø3466

1/22 **Arb. 3507'** RTD 3510' 5" @ 3508
CO 3510' FU 600' oil 3 hrs DD 3512
FU 1600' oil 2 hrs.
S/10 BOPH 3 hrs. DD 3515'
FU 1900' oil 2 hrs.
S/10 BOPH 5 hrs. POP

1/29 NR

2/5 NR

2/11 Spud 12-27-52

OilWell

TD 3515

8" @ 321

**Heeb 3219, Tor 3237, Lans 3264,
Arb. 3507**

TD 3510, 5" @ 3508, CO to 3510

FU 600' oil 3 hrs., DD 3512,

FU 1600' oil 2 hrs., S/10

boph 3 hrs., DD 3515, FU 1900'

oil 2 hrs., S/10 boph 5 hrs.

Comp. 518 bopd

COMPLETED


County **Ellis** State **Kansas**

Sec. **26** (Blk. Twp.) **13** (Sur. Rge.) **17W** Map No.

Operator **Elreco & Anschutz**

Well No. **1** Farm **Braun "B"**

Elev. Location **NW NW SW**

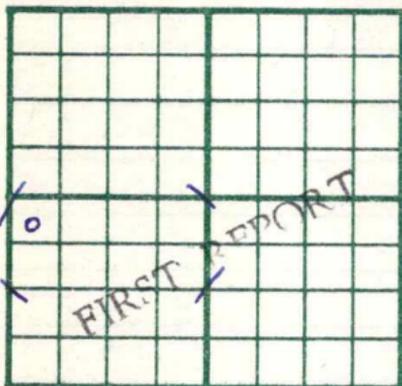

330 Ft. From **N** Line **SW**

330 Ft. From **W** Line **Quarter**

1st. Report **DEC 30 1952**

Completion

Remarks

Anschutz Drlg. - Contr.

Spudding Date **12-27-52**

Drlg. Data **Rome Pool**

8" @ 321


County Ellis State Kansas

Sec. 26 (Blk. 13) (Sur. 17W) Map No. 13

Operator Elreco & Anschutz

Well No. 1 Farm Braun "B"

Elev. 1983 Location NW NW SW

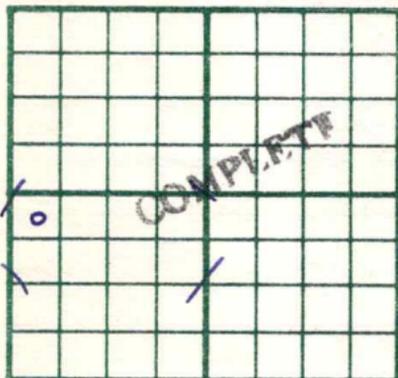

330 Ft. From N Line SW

330 Ft. From W Line Quarter

Ist. Report

Completion FEB 11 1953

Remarks Rome Pool

Anschutz Drlg. - Contr.

Spudding Date 12-27-52

Drlg. Data Oil well TD 3515

8" @ 321 Heeb. 3219 Tor. 3237


Lans. 3264 Arb. 3507 TD 3510 5" @ 3508

CO to 3510 FU 600' oil 3 hr. DD 3512

FU 1600' oil 2 hr. S/ 10 boph 3 hr.

DD 3515 FU 1900' oil 2 hr. S/ 10 boph

5 hr. Comp. 518 bopd

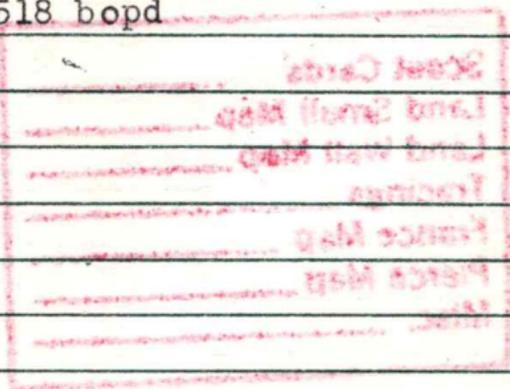

J. G. McGEHEE