


Barton KANSAS

Section 16 Township 16 Range 12-W

Well Number 5 Kultgen

Company Darby Oil

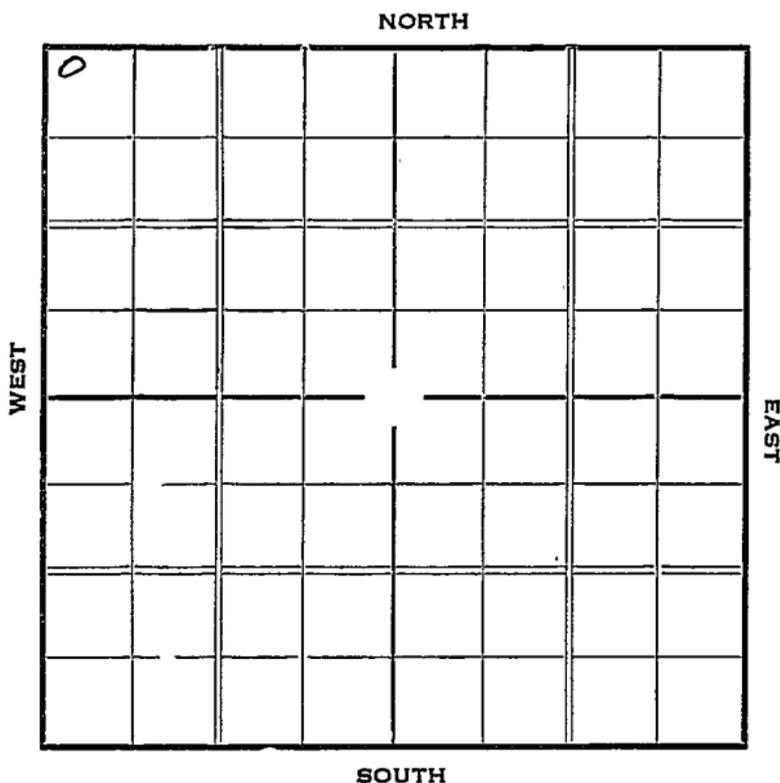

Map No. _____ Sec. 16 Twp. 16 R. 12-W

Well No. #5 Kultgen Farm _____


Darby Oil Company _____

330 Ft. from N. Line

_____ Ft. from S. Line

_____ Ft. from E. Line

330 Ft. from W. Line

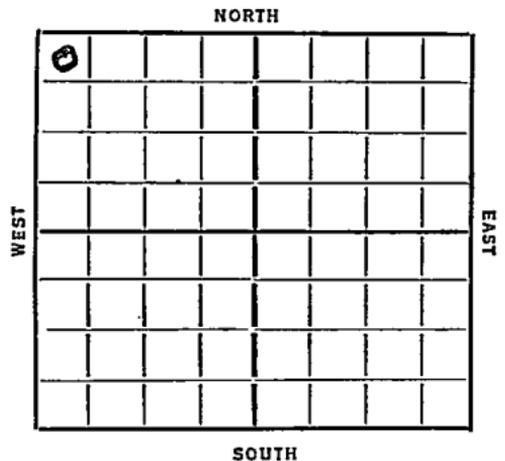

Date	REPORT
1936	
12/29	R O G
12/29	Drlg. 500'.
1937	
1/7	15" @ 335'. Anhydrate 796'.
	13" @ 800'. Drlg. 1515'.
1/14	10" @ 2134'. Drlg. 2235'.
1/21	Drlg. 2945'.
1/28	Lansing 3054'. H.F.W. 3148'.
	Show oil 3203-13' Drlg.
2/4	7" @ 3305 Conglomerate 3320'
	at 3340 had 1800' in 18 hrs.
	Drlg. 3352'
2/11	T.D. 3352 Potential 149 bbls.
2/17	Conglomerate 3320'.
	Potential 149.
	T. D. 3352'.

COMPLETED

KANSAS

Map No. 55 Sec. 16 Twp. 16 R. 12W.

Well No. 5 Kultgen

Darby Oil

Company

Contractor

SECTION PLAT

330 Ft. from N. Line

_____ Ft. from S. Line

_____ Ft. from E. Line

330 Ft. from W. Line

0			

FIRST REPORT

Location _____

Rig up _____

Drilling and Remarks:

RCG

RECORD

Cased _____ in., _____ ft.

Sand _____

Gas _____

Oil _____

Total Depth _____

PRODUCTION

1st 24 hrs. Nat. _____

1st 24 hrs. after shot _____

Gas _____ Cu. Ft.

Dry Hole _____

Abandoned _____

Date

12/16/36 19

S. J. LEWIS

Scout

KANSAS

Map No. 55 Sec. 16 Twp. 16 R. 12W

Well No. 5 Kulteem

Harty Oil Company
Contractor

SECTION PLAT

0			

330 Ft. from N. Line

_____ Ft. from S. Line

_____ Ft. from E. Line

330 Ft. from W. Line

COMPLETED

Location _____

Rig up _____

Drilling and Remarks:

Conglomerate
3320

Potential 149

RECORD

Cased _____ in., _____ ft.

Sand _____

Gas _____

Oil _____

Total Depth 3352

PRODUCTION

1st 24 hrs. Nat. _____

1st 24 hrs. after shot _____

Gas _____ Cu. Ft.

Dry Hole _____

Abandoned _____

Date

FEB 17 1937 19

S. J. LEWIS Sec