


Section 26 Township 13 Range 17W

Well No. #1 Braun

Company Wilson Etal  
Tom Allan Con.

NORTH

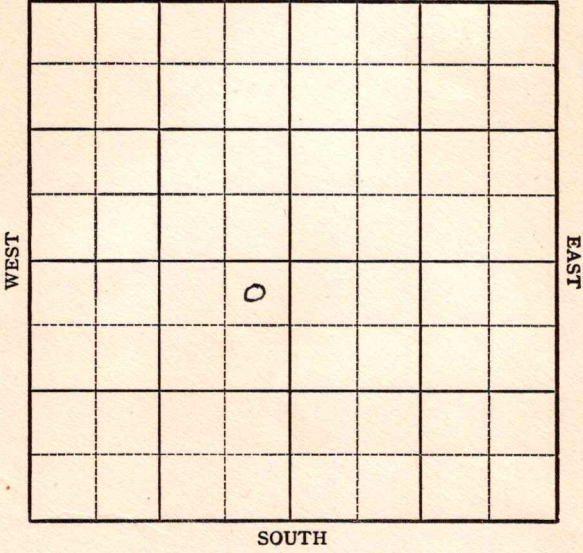

Ellis

KANSAS ✓

Sec. 26 Twp. 13 R. 17W


Well No. #1 Braun Farm

Wilson et al

Company

Wildcat (Tom Allen, Cont.)

NORTH

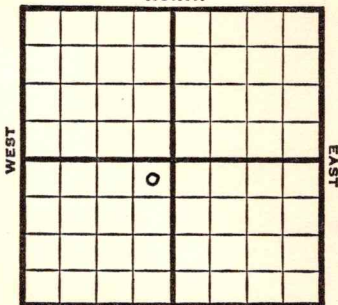

330' Ft. from N. Line

\_\_\_\_\_ Ft. from S. Line

330' Ft. from E. Line

\_\_\_\_\_ Ft. from W. Line

NE SW

SOUTH

1949 **Elev. 1955'** REPORT

8/17 14" @ 80'  
Drlg. 500'

8<sup>11</sup>/24 8" @ 1156  
Drlg. 2342

8/31 **Lansing 3259'**  
Esg 3404

9/7 **Arb 3504'**  
TD 3542'

**ABANDONED**

Map No. \_\_\_\_\_ Sec. 26 Twp. 13 R. 17W

Well No. 1 Braun

Wilson et al. Company

Tom Allan Contractor

NE SW

FIRST REPORT  
SECTION PLAT

330 Ft. from N. Line

\_\_\_\_\_ Ft. from S. Line

330 Ft. from E. Line

\_\_\_\_\_ Ft. from W. Line


Ellis County

Location \_\_\_\_\_

Rig up \_\_\_\_\_

Drilling and Remarks:

14" @ 80

drlg. 500

RECORD

Cased \_\_\_\_\_ in., \_\_\_\_\_ ft.

Sand \_\_\_\_\_

Gas \_\_\_\_\_

Oil \_\_\_\_\_

Total Depth \_\_\_\_\_

PRODUCTION

1st 24 hrs. Nat. \_\_\_\_\_

1st 24 hrs. after shot \_\_\_\_\_

Gas \_\_\_\_\_ Cu. Ft.

Dry Hole \_\_\_\_\_

Abandoned \_\_\_\_\_

Date

AUG 17 1949 19

S. J. LEWIS Scout

Kansas

Map No. 571 Sec. 26 Twp. 13 R. 17W

Well No. 1 Braun

Wilson et al. Company

**ABANDONED** Contractor

NE SW

*E 11955*  
SECTION PLAT

330 Ft. from N. Line

\_\_\_\_\_ Ft. from S. Line

330 Ft. from E. Line

\_\_\_\_\_ Ft. from W. Line

	0		

Ellis County

Location \_\_\_\_\_

Rig up \_\_\_\_\_

Drilling and Remarks:

*See 3504*

RECORD

Cased \_\_\_\_\_ in., \_\_\_\_\_ ft.

Sand \_\_\_\_\_

Gas \_\_\_\_\_

Oil \_\_\_\_\_

Total Depth 3542

PRODUCTION

1st 24 hrs. Nat. \_\_\_\_\_

1st 24 hrs. after shot \_\_\_\_\_

Gas \_\_\_\_\_ Cu. Ft.

Dry Hole \_\_\_\_\_

Abandoned \_\_\_\_\_

Date

SEP 7 1949 19

S. J. LEWIS Scout