

Ellis


DX 78-1

KANSAS

Section 26 Township 13 Range 17W

Well No. #1 Braun

Company Franco-Central

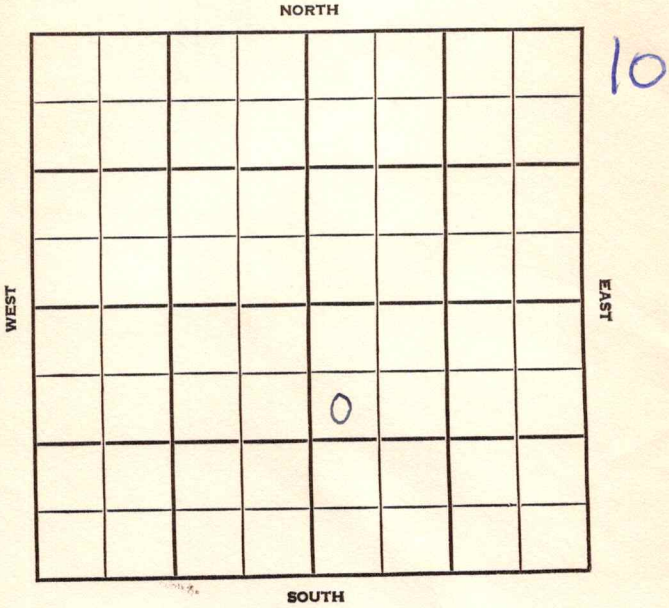

Ellis

KANSAS

SEC. 26	TWP. 13	R. 17W
------------	------------	-----------

WELL NO. #1 Braun FARM

COMPANY Franco-Central


CONTRACTOR Todd Drlg.

990 _____ Ft. from N. Line

_____ Ft. from S. Line

_____ Ft. from E. Line

330 _____ Ft. from W. Line

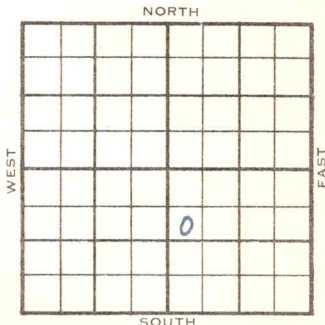

SW NW SE

1955	ELEVATION 1965	REPORT
------	-------------------	--------

4/6 Location

6/8
 Comm 4-11-55
 8 5/8" @ 180/120
 5 1/2" @ 3513/150
 Tp 2960, H 3222, Tr 3244, L 3268,
 A 3512, TD 3515,
 DD 3544, 1500 A S/41 bo 10 hr.
 P.40 bf 20% wtr 24 hr
 Comp 39 bopd

COMPLETED

County Ellis Elev. 1964
 Sec. 26 Twp. 13 Rge. 17W
 Company Franco-Central
 Farm Name Braun No. 1

TOPS	DEPTH	LOG	DATUM	Loc. in Sec.	
Anh.				SW NW SE	
Tp.	2960		996	
H.	3222		1258	
Tr.	3244		1280	
Dg.				Geol.	
Bl.	
L.	3268		1304	Contr.	
K.C.	
B.K.C.				Todd Drlg.	
Ce.	
C.				Pool	
M.	
M.				<table border="1"> <tr><td></td><td></td><td></td><td></td></tr> <tr><td></td><td></td><td></td><td></td></tr> <tr><td></td><td></td><td></td><td></td></tr> <tr><td></td><td></td><td></td><td></td></tr> <tr><td></td><td></td><td></td><td></td></tr> <tr><td></td><td></td><td></td><td></td></tr> <tr><td></td><td></td><td></td><td></td></tr> <tr><td></td><td></td><td></td><td></td></tr> <tr><td></td><td></td><td></td><td></td></tr> <tr><td></td><td></td><td></td><td></td></tr> </table>	
K.	
Mz.	
Me.	
V.	
S.	
S.	
A	3512		1548	
R.	
Pe.	
G.	
T.D.	3515	

Date Comm. 4-11-55 JUN 8 1955

8 5/8" @ 100/120 5 1/2" @ 3513/150
 DD 3544 1500 A S/ 41 bo 10 hr.
 P/ 40 bf 20% wtr. 24 hr.
 Comp. 39 bopd

Co.
Lse.
No.
Sec.
T.
R.