
Form 51—5M—3-35—Mid-West

Map No. KANSAS Sec. 16 Twp. 16 R. 12 Barton

Well No. 2 Kultgen Farm

Darby Pet Company

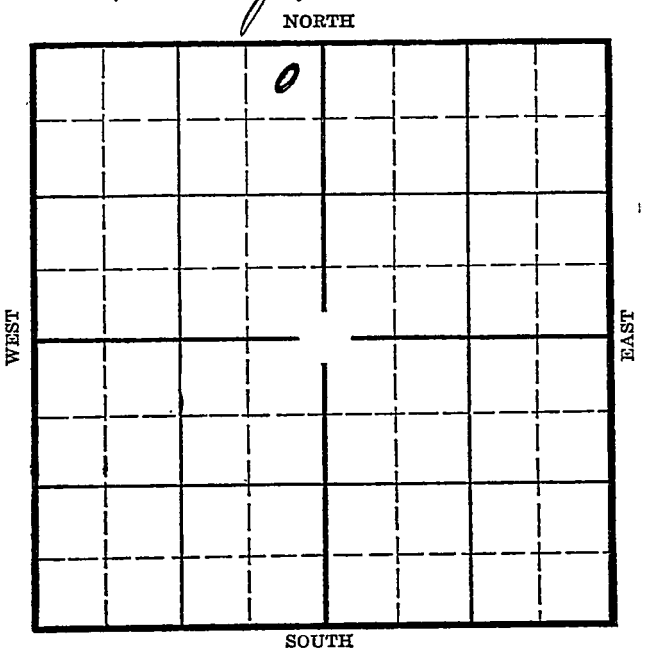

Location

Drilling Remarks

Rig Up

Drilling Remarks

RECORD

Cased ____ in. ____ ft.

Sand

Gas

Oil

Total Depth

PRODUCTION

1st 24 hrs. Nat.

1st 24 hrs. after shot

Gas ____ cu. ft.

Dry Hole

Abandoned

Form 252-A
5M 7-34 MPC

Barton

Map No. KANSAS Sec. 16 Twp. 16 R. 12 W

Well No. 2 - Kultgen Farm


Darby Pet Company

330 Ft. from N. Line

Ft. from S. Line

330 Ft. from E. Line

Ft. from W. Line

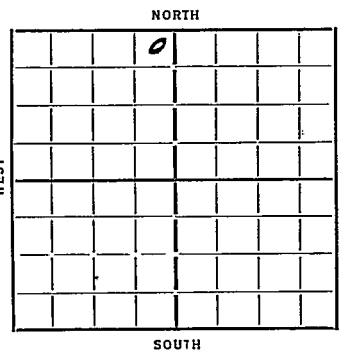

Elev. 1902

Date	REPORT
1935	
6/26	Cellar
7/3	Moving
7/14	Spud
7/18	15" 366 6 2 2 run 13"
8/8	Dly 2550
8/15	" 3025
8/22	Lansing 3075 6" 3332
	TJ 3361 Sand 3346½
	1000' 6 hrs WOC.
8/29	PB 3
9/6	PB 3353
9/12	Sand 3346½
	TJ 3361
	PB 3353
	320 Bbls.
	COMPLETED

Form 26—1M Bk—9-28 KANSAS

Barton


Map No. 55 Sec. 16 Twp. 16 R. 12 W

Well No. 2 Kuntzen

Daby Jet. Company

Contractor

SECTION PLAT

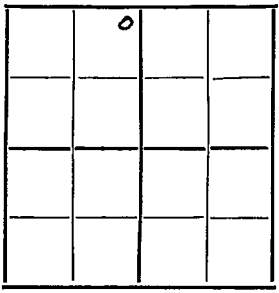

330 Ft. from N. Line

Ft. from S. Line

330 Ft. from E. Line

Ft. from W. Line

FIRST REPORTS

Location

Rig up

Drilling and Remarks:

Cellar.

RECORD

Cased in., ft.

Sand

Gas

Oil

Total Depth

PRODUCTION

1st 24 hrs. Nat.

1st 24 hrs. after shot

Gas Cu. Ft.

Dry Hole

Abandoned

Date

6/26/35 192

ORVAL MANNSCHRECK Scout

Form 26—1M Bks.—9-26

Barton KANSAS

Map No. 55 Sec. 16 Twp. 16 R. 12W


Well No 2 - Kultgen

Darby Pet Company

Contractor

COMPLETED

SECTION PLAT

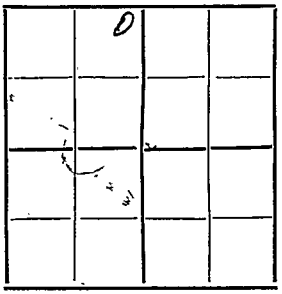

330 Ft. from N. Line

Ft. from S. Line

330 Ft. from E. Line

Ft. from W. Line

Location

Rig up

Drilling and Remarks:

PB 3353

320 bbls

RECORD

Cased in., ft.

Sand 3346½

Gas

Oil

Total Depth 3361

PRODUCTION

1st 24 hrs. Nat.

1st 24 hrs. after shot

Gas Cu. Ft.

Dry Hole

Abandoned

Date

9-12-35 192

ORVAL MANNSCHRECK Scout