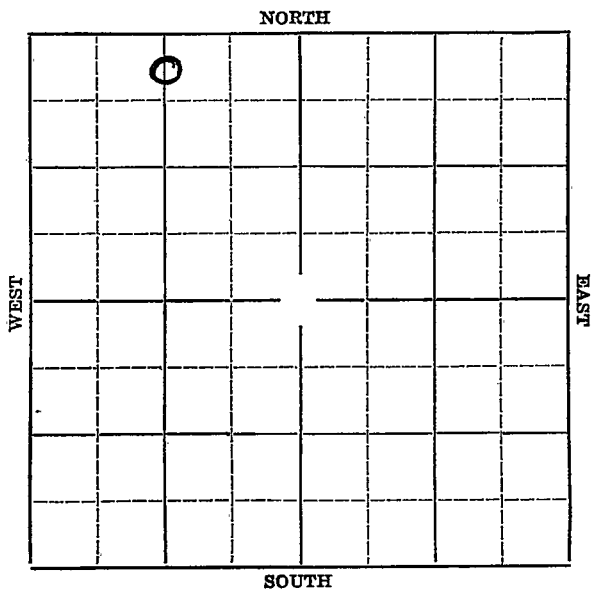


Section 16 Township 16 Range 12WWell Number #3 KultgenCompany Darby Oil

Barton

Map No. KANSAS Sec. 16 Twp. 16 R. 12W

Well No. #3 Kultgen Farm

Darby Oil. Company


330' Ft. from N. Line

 Ft. from S. Line

1320' Ft. from E. Line

 Ft. from W. Line

Elev. 1910

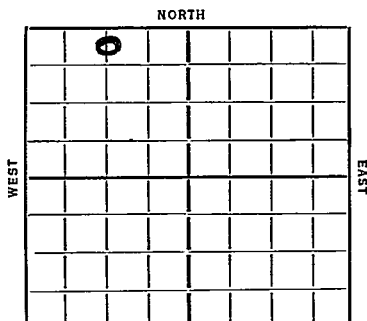


Date	REPORT
1936	
6/3	Rig on ground.
6/11	Rig.
6/18	Rigging up.
6/25	Spud.
7/2	Anhy. 817'. Set 10" Drlg. 900'.
7/9	Drlg. 1710'.
7/16	Drlg. 2500'.
7/23	Drlg. 2840'.
7/30	Lansing 3070'. Drlg. 3323'.
8/6	Siliceous 3343'. T.D. 3352'. 1500' of oil in 4 hours.
8/12	/36-Sil. 3343'.
	T.D. 3352'.
	929 bbls of oil natural.
	COMPLETED

KANSAS

Map No. 55 Sec. 16 Twp. 16 R. 12 WWell No. 3 KullgrenHarby Oil Company

Contractor

SECTION PLAT

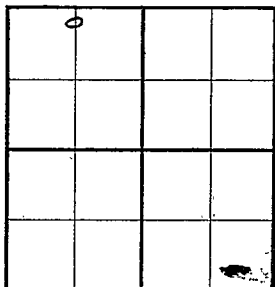330 Ft. from N. Line

_____ Ft. from S. Line

1320 Ft. from E. Line

_____ Ft. from W. Line

FIRST REPORT

Location _____

Rig up _____

Drilling and Remarks:

ROG

RECORD

Cased _____ in., _____ ft.

Sand _____

Gas _____

Oil _____

Total Depth _____

PRODUCTION

1st 24 hrs. Nat. _____

1st 24 hrs. after shot _____

Gas _____ Cu. Ft.

Dry Hole _____

Abandoned _____

Date

JUN 3 1936 19

S. J. LEWIS Scout

KANSAS

Map No. 55 Sec. 16 Twp. 16 R. 12WWell No. 3 KuttgenHarby CompanyHarby Contractor

SECTION PLAT

10		

320 Ft. from N. Line Ft. from S. Line1320 Ft. from E. Line Ft. from W. Line

COMPLETED

Location Rig up

Drilling and Remarks:


RECORD

Cased in., ft.Sand Gas Oil Total Depth 3352

PRODUCTION

1st 24 hrs. Nat. 1st 24 hrs. after shot Gas Cu. Ft.Dry Hole Abandoned

Date

AUG 12 1936 19

S. J. LEWIS Scout