


Section 16 Township 16 Range 12-W

Well Number #4-Kultgen

Company Darby Oil

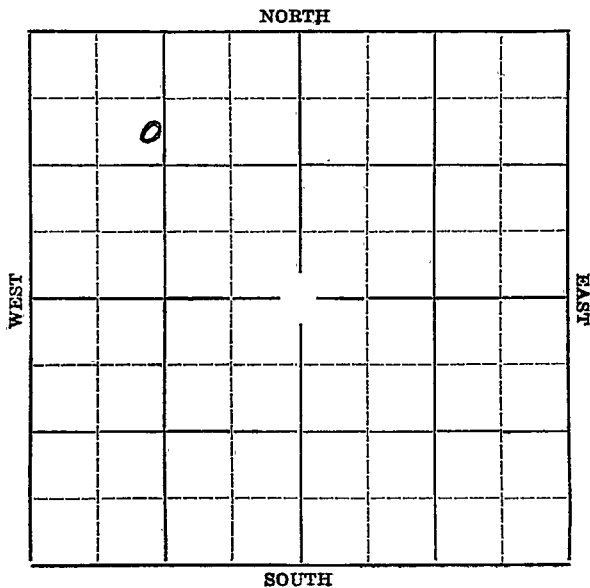

Sec. 16 Twp. 16 R. 12WWell No. #1 Kultgen FarmDarby Oil. Company

NORTH

990' Ft. from N. Line


Ft. from S. Line

Ft. from E. Line

1300' Ft. from W. Line

Elev. 1907

SOUTH

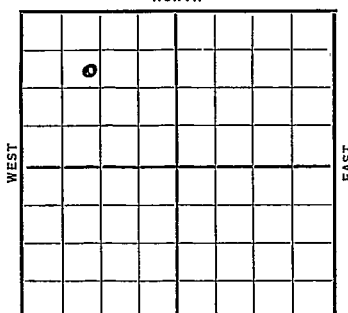

D236

REPORT

8/19 Rig on ground.

8/27 Rigging up.

9/3 15" @ 360'. Drlg. 500'.

9/10 Drilg. 1065'.

9/18 10" @ 2122'. Drlg. 2170'.

9/24 Drlg. 2895'.

10/1 Oswald 3080'. Water 3210'.

8" @ 3330' drilling.

10/8 6" @ 3341'. Top Sil. 1400' of oil

3385-86'. T.D. Pump 107 bbls of
oil and 53 bbls of water in 7 hr10/15 T.D. 3404'. Pump 5 bbls of oil
3 bbls of water per hour.

10/22 Shut down.

10/29--11/6--

11/10 Sil. 3342 T. D. 3417

235 Oil 67 Water

COMPLETED

KANSAS

Map No. 58 Sec. 16 Twp. 16 R. 12WWell No. 4 KullgrenHarby Oil Company

Contractor

SECTION PLAT

0			

990 Ft. from N. Line

_____ Ft. from S. Line

_____ Ft. from E. Line

1300 Ft. from W. Line

FIRST REPORT

Location _____

Rig up _____

Drilling and Remarks:

ROG.

RECORD

Cased _____ in., _____ ft.

Sand _____

Gas _____

Oil _____

Total Depth _____

PRODUCTION

1st 24 hrs. Nat. _____

1st 24 hrs. after shot _____

Gas _____ Cu. Ft.

Dry Hole _____

Abandoned _____

Date

AUG 19 1936 19

S. J. LEWIS Scout

KANSAS

Map No. 55 Sec. 16 Twp. 16 R. 12W

Well No. 4 Kulligan

Tardy Oil Company

Contractor

SECTION PLAT

990 Ft. from N. Line

_____ Ft. from S. Line

_____ Ft. from E. Line

1300 Ft. from W. Line

COMPLETED

Location _____

Rig up _____

Drilling and Remarks:

Oil 3341

235 Oil

67 Water

RECORD

Cased _____ in., _____ ft.

Sand _____

Gas _____

Oil _____

Total Depth 3412

PRODUCTION

1st 24 hrs. Nat. _____

1st 24 hrs. after shot _____

Gas _____ Cu. Ft.

Dry Hole _____

Abandoned _____

Date

NOV 10 1930 19

S. J. LEWIS

Scout