

26

13

17W

SECTION _____ TOWNSHIP _____ RANGE _____


#5 Braun "B"

WELL NO. _____

Eldorado Ref. & Anschutz

COMPANY _____

NORTH

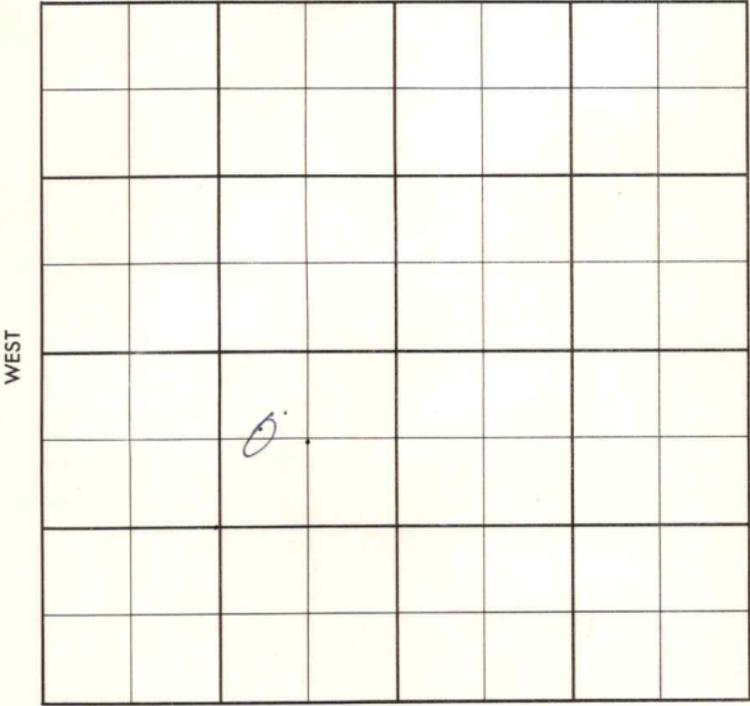

SOUTH

WEST

EAST

County Ellis Elev. 1954
 Sec. 26 Twp. 13 Rge. 17W
 Company Eldorado Ref. & Anschutz
 Farm Name Braun "B" No. 5

TOPS	DEPTH	LOG	DATUM	Loc. in Sec.				
Anh.				C W/2 NE SW				
Tr.								
H.	3205							
Tr.								
Dg.								
Bl.								
L.	3254			Geol.				
K.C.				Concr.				
B.K.C.				Dutch Tools				
Ce.				Pool				
C.				Sugarloaf, SE				
M.				<table border="1"> <tr><td colspan="2">COMPLETE</td></tr> <tr><td colspan="2">OCT 31 '56</td></tr> </table>	COMPLETE		OCT 31 '56	
COMPLETE								
OCT 31 '56								
M.								
K.								
Mz.								
Me.								
V.								
S.								
S.	3495							
A.								
R.								
Pe.								
G.								
TD.	3500							

Date Comm. _____
 Location SEP 26 '56 9-21-56 85/8
300 1175 D 2745 OCT 3 '56
5 1/2 3496 / OCT 10 '56 CO 3500
45 + 15 1/2 GO 1 hr \$ 1.67
Boph 6 hrs 300 acid \$
54.15 BO + 8 GW 6 hrs
30' O. B. POP. OCT 17 '56 OCT 24 '56 OCT 31 '56
Ph P. 215 Bopd Nolwh
graw 36.3°

747156

FORM 513 SUNRAY

County Ellis Elev. _____
 Sec. 26 Twp. 13 Rge. 17W
 Company Eldorado Ref. & Anschutz
 Farm Name Braun "B" No. 5

TOPS	DEPTH	LOG	DATUM
Anh.			
Tp.			
H.			
Tr.			
Dg.			
Bl.			
L.			
K.C.			
B.K.C.			
Ce.			
C.			
M.			
M.			
K.			
Mz.			
Me.			
V.			
S.			
S.			
A			
R.			
PE.			
G.			
T.D.			

Loc. in Sec. C W/2 NE SW
 Geol. _____
 Contr. _____
Dutch Tools
 Pool _____
Sugarloaf, SE

FIRST REPORT
 SEP 19 '56

Date Comm. _____
 Location SEP 26 '56

SEP 5 '56

R.O.A

Co.
Lsc.
No.
Sec.
T.
R.