


Barton

KANSAS

Section 16 Township 16 Range 12-W

Well No. 2 J. Kultgen

Company Paul Martin et al

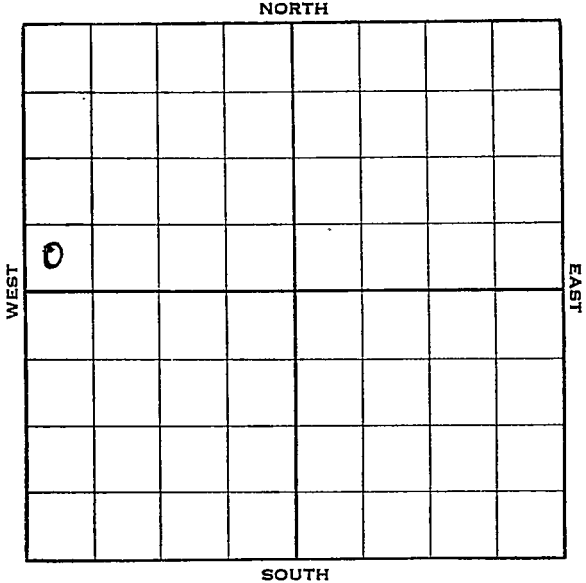


Sec. 16 Twp. 16 R. 12-WWell No. #2 J. Kultgen FarmPaul Martin et al Company

\_\_\_\_\_ Ft. from N. Line

330 Ft. from S. Line

\_\_\_\_\_ Ft. from E. Line

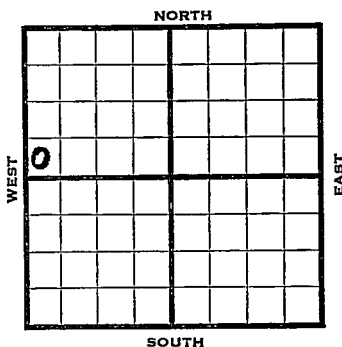330 Ft. from W. Line

Elev. 1905

| 1938  | REPORT                        |
|-------|-------------------------------|
| 10/12 | C. R.                         |
| 10/21 | R. U.                         |
| 10/28 | 20" - 83'. Dlg. - 500'.       |
| 11/4  | 15" - 525'. Anhy 807'.        |
|       | 12" - 807'. Dlg. 1345'.       |
| 11/12 | S.D. 1905'.                   |
| 11/18 | " "                           |
| 11/25 | T. D. 2100'. Rng. 10".        |
| 12/2  | 10" - 2110'. Drlg. 2715'.     |
| 12/9  | Lans. 3069'. 2 B.W. 3150-60'. |
|       | 8" - 3160'. Dlg. 3170'.       |
| 12/15 | 8" - 3168'. Cong. 3330'.      |
|       | Gorham 3347-54' T.D.          |
|       | 1000' fluid 12 hrs.           |
|       | Running liner.                |
| 12/21 | 6" - 3344'.                   |
|       | Gorham 3347'.                 |
|       | T. D. 3354'.                  |
|       | Potential 807 bbls.           |
|       | <b>COMPLETED</b>              |

Barton

KANSAS

Map No. 53 Sec. 16 Twp. 16 R. 12WWell No. 2 J. KultgenPaul Martin etal

Company

Contractor

## FIRST REPORT

## SECTION PLAT

SW NW

Ft. from N. Line

330

Ft. from S. Line

Ft. from E. Line

330

Ft. from W. Line

|   |  |  |  |
|---|--|--|--|
|   |  |  |  |
| 0 |  |  |  |
|   |  |  |  |
|   |  |  |  |

Location \_\_\_\_\_

Rig up \_\_\_\_\_

Drilling and Remarks:

CR

## RECORD

Cased \_\_\_\_\_ in., \_\_\_\_\_ ft.

Sand \_\_\_\_\_

Gas \_\_\_\_\_

Oil \_\_\_\_\_

Total Depth \_\_\_\_\_

## PRODUCTION

1st 24 hrs. Nat. \_\_\_\_\_

1st 24 hrs. after shot \_\_\_\_\_

Gas \_\_\_\_\_ Cu. Ft.

Dry Hole \_\_\_\_\_

Abandoned \_\_\_\_\_

Date

OCT 12 1938

19

H. D. Hatfield

Scout

Barton **KANSAS**Map No. 55 Sec. 16 Twp. 16 R. 12WWell No. 2 J. KultgenPaul Martin et al Company

Contractor

**COMPLETED****SECTION PLAT**

SW NW

\_\_\_\_\_ Ft. from N. Line

330 Ft. from S. Line

\_\_\_\_\_ Ft. from E. Line

330 Ft. from W. Line

BEAVER POOL

|   |  |  |  |
|---|--|--|--|
|   |  |  |  |
| 0 |  |  |  |
|   |  |  |  |
|   |  |  |  |

Location \_\_\_\_\_

Rig up \_\_\_\_\_

Drilling and Remarks: \_\_\_\_\_

Pot 807

**RECORD**Cased 6 in., 3344 ft.Sand Gorham 3347

Gas \_\_\_\_\_

Oil \_\_\_\_\_

Total Depth 3354**PRODUCTION**

1st 24 hrs. Nat. \_\_\_\_\_

1st 24 hrs. after shot \_\_\_\_\_

Gas \_\_\_\_\_ Cu. Ft.

Dry Hole \_\_\_\_\_

Abandoned \_\_\_\_\_

Date

H. D. Hatfield

DEC. 21 1938 19

Scout