
Form 51-5M 5-37 Petrol

Barton KANSAS

Section 16 Township 16 Range 12-W

Well No. 2 - Meyer

Company Polk & Fortson

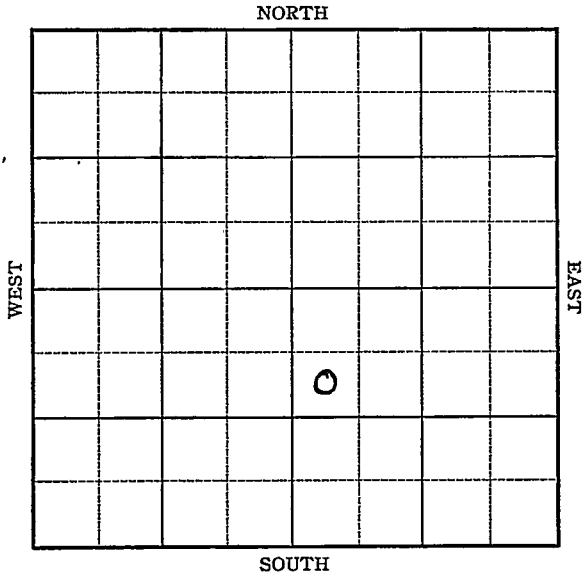

Form 252-A—5M—2-37—Palace KANSAS Barton

Sec. 16 Twp. 16 R. 12-W

Well No. #2 Meyer Farm


Polk & Fortson Company

990 Ft. from N. Line

Ft. from S. Line

Ft. from E. Line

330 Ft. from W. Line

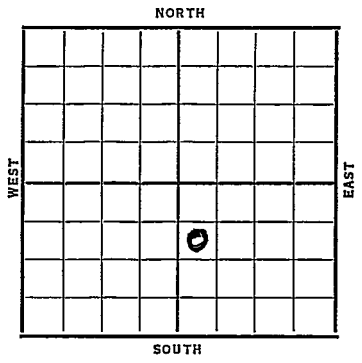

Elev. 1904

Date	REPORT
1937	
8/18	10" @ 117'. K.C. 3070'.
	Drlg. 3215'.
8/28	Cong. 3335'. T.D. 3346'.
	Sat. in samples 3343-46'.
	7" @ 3336'. RUST.
9/3	600' oil 6 hrs. @ 3337-42'.
	2000' oil @ 3346'. 2300' oil.
	in 12 hrs. T.D. 3347'.
	2500' oil 16 hrs.
9/10	" " "
9/17	T.D. 3347'. Testing.
9/22	Cong. 3335'.
	T.D. 3347'.
	Pump 455 bbls.
	COMPLETED

Form 26—1M Bks.—2-29 Barton KANSAS

Map No. 558 Sec. 16 Twp. 16 R. 12 W

Well No. 2 - Meyer

Polk & Gorton Company

Contractor

FIRST REPORT


990 Ft. from N. Line

Ft. from S. Line

Ft. from E. Line

330 Ft. from W. Line

SECTION PLAT

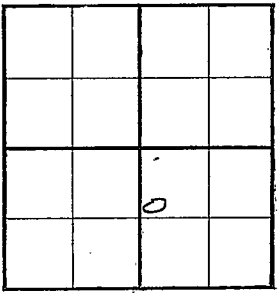

Location

Rig up

Drilling and Remarks:

10"—117

K.C. 3070

Dlg 3215

RECORD

Cased in., ft.

Sand

Gas

Oil

Total Depth

PRODUCTION

1st 24 hrs. Nat.

1st 24 hrs. after shot

Gas Cu. Ft.

Dry Hole

Abandoned

Date

AUG 18 1937 19

H. D. Hatfield Scout

Form 26—5M Blk. 2-29 Boston

KANSAS


Map No. _____ Sec. 16 Twp. 16 R. 12W

Well No. 2- Meyer

Rolk & Fortson Company

_____ Contractor

SECTION PLAT

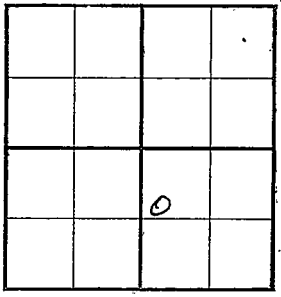

990 Ft. from N. Line

_____ Ft. from S. Line

_____ Ft. from E. Line

330 Ft. from W. Line

COMPLETED

Location _____

Rig up _____

Drilling and Remarks:

Pump
455 bbls

RECORD

Cased _____ in., _____ ft.

Sand Long. 3335

Gas _____

Oil _____

Total Depth 3347

PRODUCTION

1st 24 hrs. Nat. _____

1st 24 hrs. after shot _____

Gas _____ Cu. Ft.

Dry Hole _____

Abandoned _____

Date

SEP 22 1937

19 _____

H. D. Hatfield Scout