





Sec. 26 Twp. 13 R. 17 W

Well No. # 1 Rome Farm

Eldorado & Anschutz Drlg. Company

Anschutz Drlg. Contractor


\_\_\_\_\_ Ft. from N. Line

990 Ft. from S. Line

\_\_\_\_\_ Ft. from E. Line

330 Ft. from W. Line

NW SW SW

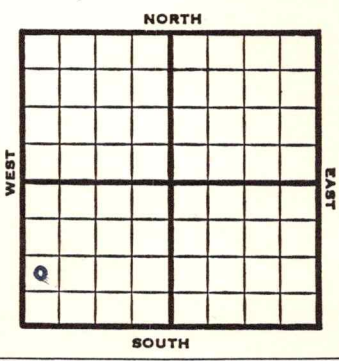

1953 Elev. 1980' REPORT

2/25 Spud 2-18-53  
 8" @ 318 Anhy 1178'  
 Drlg. 2325

3/4 Spud 2-18-53  
 D&A  
 TD 3573  
 8" @ 318  
 Anhy 1178, Heeb 3229, Tor 3251,  
 Lans 3278, Cong 3517, Arb 3548  
 DST 3555-63, opn 1 hr., rec. 5'  
 mud  
 DST 3557-73, opn 1 hr., rec.  
 15' mud, 340#  
 TD 3573  
 D&A

**ABANDONED**

County Ellis State Kansas

Sec. 26 (Blk. 13 (Sur. 17W (Twp.) 13 (Rge.) 17W Map No.

Operator Eldorado & Anschutz Drlg.

Well No. 1 Farm Rome

Elev. \_\_\_\_\_ Location NW SW SW


FIRST REPORT

990 Ft. From S Line SW

330 Ft. From W Line Quarter

1st. Report FEB 25 1953

Completion \_\_\_\_\_

Remarks \_\_\_\_\_

Anschutz Drlg. - Contr.

Spudding Date 2-18-53

Drlg. Data \_\_\_\_\_

8" @ 318 Any 1178 drlg. 2325


County Ellis State Kansas

Sec. 26 (Blk. 13) (Sur. 17W) (Twp.) (Rge.) Map No.

Operator Eldorado & Anschutz Drlg.

Well No. 1 Farm Rome

Elev. 1980 Location NW SW SW

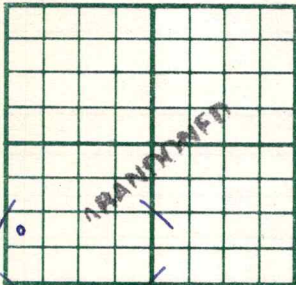

990 Ft. From S Line SW

330 Ft. From W Line Quarter

1st. Report

Completion MAR 4 1953

Remarks

Anschutz Drlg. - Contr.

Spudding Date 2-18-53

Drlg. Data D & A TD 3573

8" @ 318 Anhy 1178 Heeb. 3229

Tor. 3251 Lans. 3278 Cong. 3517

Arb. 3548 DST 3555-63 open 1 hr.

Rec. 5' mud DST 3557-73 open 1 hr.

Rec. 15' mud 340# TD 3573

