


DX 78-1

Section 16 Township 16 Range 12W

Well No. #2 Kultgen "E"

Company Franco-Central

NORTH

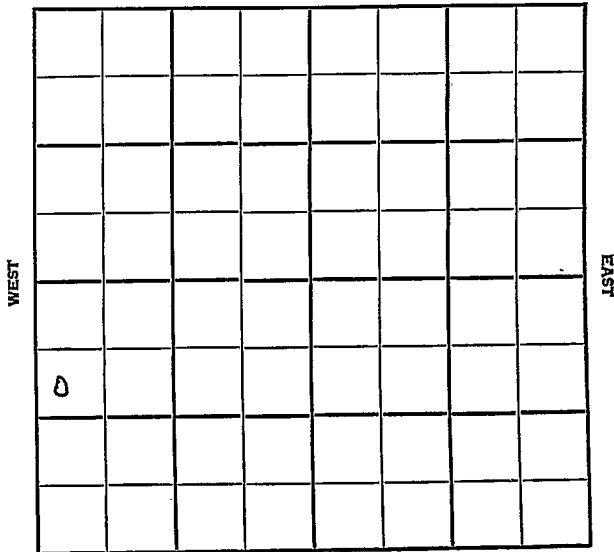

SOUTH

[Handwritten mark]

Barton

KANSAS

SEC.	TWP.	R.
16	16	12 W

WELL NO. # 2 Kultgen "E" FARM

COMPANY Franco-Central

CONTRACTOR Lewis Drlg.

Beaver Pool


990 Ft. from N. Line

Ft. from S. Line

Ft. from E. Line

330 Ft. from W. Line

SW NW SW

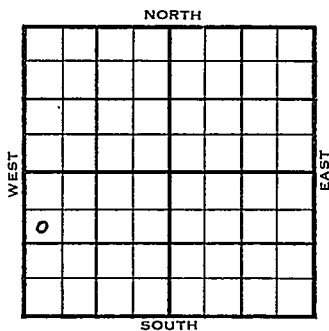

	ELEVATION	REPORT
1954	1971'	

9/8 Spud 9-6-54
8" @ 341 WOC

11/23 Spud 9-6-54
Oil Well
TD 3372'
8" @ 341'
Heeb 2989', Br Lime 3077' Lans 3088'
Chert. 3360'
DST 3360'-65' opn 1 hr, rec 4' Mud Off
TD 3372'
5" @ 3369'
CO to 3372' 3 go 3 gw 8 hr.
hydro. S/ 3 $\frac{1}{2}$ bf 10 hr. P/ 4 bo
26 bwpd.
Comp 8-10 bopd. lots of wtr.

COMPLETED

