

GEOLOGICAL DEPARTMENT
SOUTHWESTERN GAS COMPANY

INDEPENDENCE, KANSAS

Company Franklin Drilling Company,
Chanute, Kansas.

S. T. R. 21-28-17
County Wilson
State Kansas
Lease and Dewey Est. #4
Well No.

Contractor Company Tools.

Drilling Commenced 9/1/25.

Drilling Completed 9/20/25.


Initial Production Shale gas well

Initial Rock Pressure

Location SW corner of Sec.

Casing 8 1/2" 23'
6 1/2" 355

Packer set at 632 1/2'

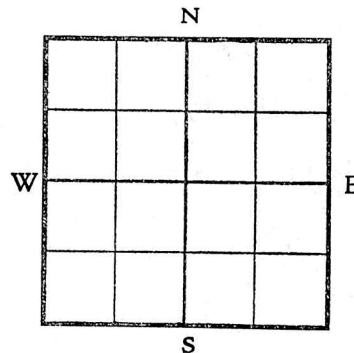

Driller's Record of Formations

10	soil clay	10
15	shale	25
10	lime	35
40	sand	75
20	lime	95
10	shale	105
5	lime	110
20	shale	130
25	shale	155
35	lime	190
35	lime	225
25	lime	250
5	shale black	255
15	lime	270
10	lime	280
15	shale	295
25	lime	320
20	lime	340
15	shale	355
20	shale	375
5	lime	380
5	shale	385
50	shale	435
5	lime	440
10	shale	450
10	lime	460
35	shale	495
55	shale	550
35	lime	585
40	shale	625
10	lime	635
10	lime	645
7	black shale	652
5	lime	657
5	shale black	662
3	lime	665
5	shale black	670