

Section 26 Township 13 S Range 17 WWell No. #2 RomeCompany El Dorado Ref.

NORTH

WEST

EAST

SOUTH

14

0

Ellis

KANSAS
KANSAS

SEC.	TWP.	R.
26	13S	17W

WELL NO.

#2 Rome

FARM

COMPANY

El Dorado Ref

CONTRACTOR

Rome


Ft. from N. Line

Ft. from S. Line

Ft. from E. Line

Ft. from W. Line

X NW SE SW

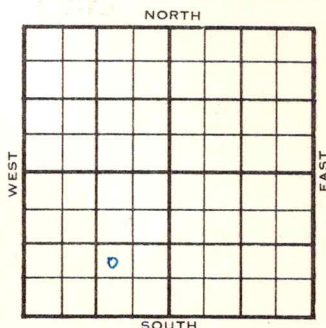

1955

ELEVATION

REPORT

9/28

Comm 9-23-55
8" @ 352 w/160
D 2160

10/12

Comm 9-23-55
8" @ 352/160

H	3221
Tr	3239
L	3268
C	3503
A	3513
TD	3557

DST 3514-17 open 1/2 hr Rec 100' mud
DST 3517-22 open 1 hr Rec 60' gassy
mud 1310# DST 3522-32 open 1 hr
Rec 10' ocm 0# DST 3532-42 open 1 hr
Rec 35' mud 0#
D & A

ABANDONED

County Ellis

Elev. _____

Sec. 26Twp. 13SRge. 17WCompany El Dorado Ref.Farm Name RomeNo. 2

TOPS

DEPTH

LOG

DATUM

Loc. in Sec. _____

Anh. _____

Tp. _____

H. _____

Tr. _____

Dg. _____

B.L. _____

L. _____

K.C. _____

B.K.C. _____

Ce. _____

C. _____

M. _____

M. _____

K. _____

Mz. _____

Mq. _____

V. _____

S. _____

S. _____

A. _____

R. _____

P.E. _____

G. _____

T.D. _____

NW SE SW

Geol. _____

Contr. _____

Pool _____

Rome

FIRST REPORT

0

Co.

Lse.

No.

Sec.


T.

R.

Date Comm. 9-23-55

SEP 28 1955

8" 352 w/160; D 2160

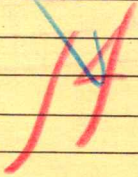

County Ellis

Elev. _____

Sec. 26Twp. 13Rge. 17W

Company _____

ElDorado Ref.

Farm Name _____

RomeNo. 2

TOPS

DEPTH

LOG

DATUM

Loc. in Sec. _____

Anh.

Tp.

H.

Tr.

Dg.

Bl.

L.

K.C.

B.K.C.

Ce.

C.

M.

M.

K.

Mz.

Mq.

V.

S.

S.

A.

R.

P.E.

G.

T.D.

32213239326835033513355712541272130115361546

NW SE SW

Geol. _____

Contr. _____

Anschutz

Pool

Rome

ABANDONED

Date Comm. 9-23-55

OCT 12 1955

8" @ 352/160

DST 3514-17

open $\frac{1}{2}$ hr.

Rec. 100' mud

DST 3517-22

open 1 hr.

Rec. 60' gassy mud

1310#

DST 3522-32

open 1 hr.

Rec. 10' ocm

Off

DST 3532-42

open 1 hr.

Rec. 35' mud

Off

D & A