


Section 26 Township 13 Range 17 W

Well No. # 1 Von Lintel

Company Bell Bros.

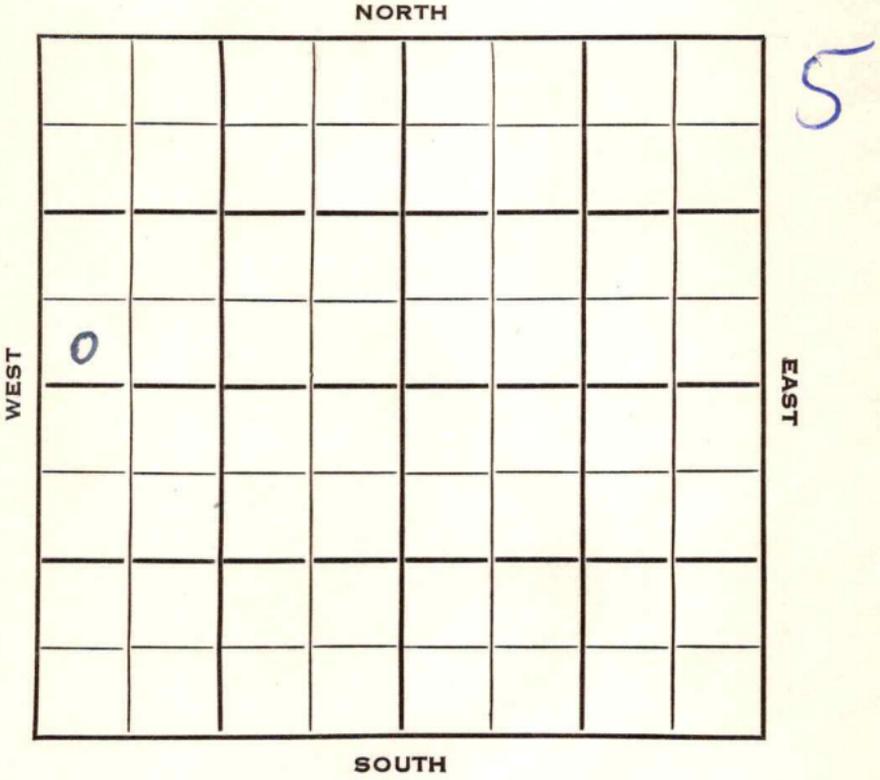

Sec. 26 Twp. 13 R. 17W

Well No. #1 Von Lintel Farm

Bell Bros. Company

Murfin Drlg. Contractor


\_\_\_\_\_ Ft. from N. Line

330 Ft. from S. Line

\_\_\_\_\_ Ft. from E. Line

330 Ft. from W. Line

SW SW NW

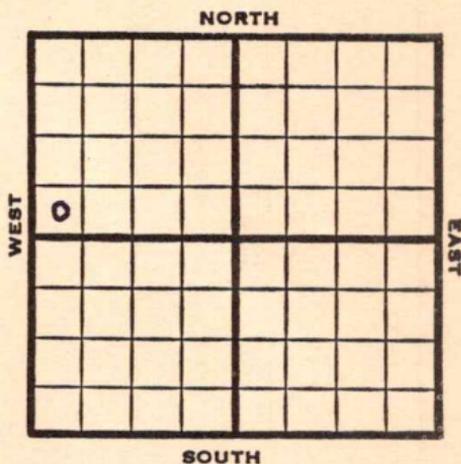

1952 **Elev. 1983'** REPORT

12/3 Spud 11-30-52

12/4 " (First Report)

12/11 8" @ 125 Heeb 3226 Tor 3245 Lans 3274  
Ø3290

12/18 Arb 3515 RTD 3518 5"3516 RUST

12/25 " " " " "

1/1 NR

1/8 NR

1/22 DD 3519' S/8 BOPH 500 A

1/29 S/13 BOPH 6 hrs., POP

2/5 NR

2/11 Spud 11-30-52

Oil Well

TD 3519

8" @ 125

**Heeb 3226, Tor 3245, Lans 3274,**

**Arb. 3515**

TD 3518

5" @ 3516

CO to 3518

S/10 boph DD 3519 S/8 boph

500A S/13 boph

Comp. 2710 boph

**COMPLETED**

County **Ellis** State **Kansas**

Sec. **26** (Blk. Twp.) **13** (Sur. Rge.) **17W** Map No.

Operator **Bell Bros.**

Well No. **1** Farm **Von Lintel**

Elev. Location **SW SW NW**


**330** Ft. From **S** Line **NW**

**330** Ft. From **W** Line **Quarter**

Ist. Report **DEC 3 1952**

Completion

Remarks

**Murfin Drlg. - Contr.**

Spudding Date **11-30-52**

Drlg. Data

FIRST REPORT

County Ellis State Kansas

Sec. 26 (Blk. 13) (Sur. Rge.) 17W Map No.

Operator Bell Bros.

Well No. 1 Farm Von Lintel

Elev. 1983 Location SW SW N W


330 Ft. From S Line NW

330 Ft. From W Line Quarter

1st. Report

Completion FEB 11 1953

Remarks

Murfin Drlg. - Contr.

Spudding Date 11-30-52

Drlg. Data Oil well TD 3519


8" @ 125 Heeb. 3226 Tor. 3245

Lans. 3274 Arb. 3515 TD 3518

5" @ 3516 CO to 3518 S/ 10 boph

DD 3519 S/ 8 boph 500 A S/ 13 boph

Comp. 2710 bopd

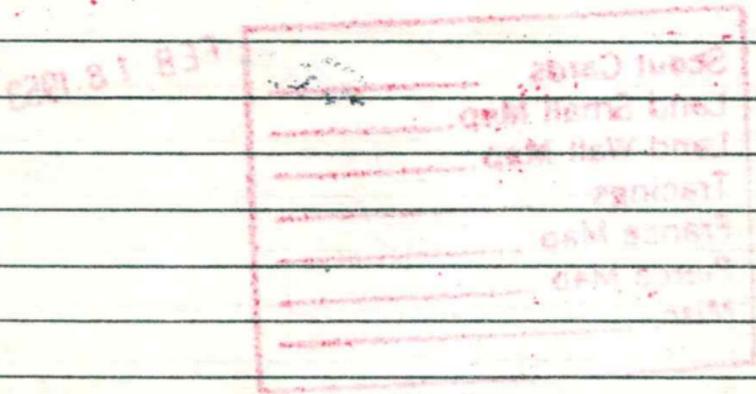

J. G. McGEHEE