

22-28-175
CPD

STATE CORPORATION COMMISSION OF KANSAS
OIL & GAS CONSERVATION DIVISION
WELL COMPLETION OR RECOMPLETION FORM
ACO-1 WELL HISTORY

DESCRIPTION OF WELL AND LEASE

Operator: license # 5491
name W. & W. Production Co.
address R. R. 2 Box 98 Chanute, Ks. 66720
City/State/Zip

Operator Contact Person K.J. or Michael Wimsett
Phone 1-316-431-4137

Contractor: license # 5490
name Wimsett Oil Inc.

Wellsite Geologist None
Phone

Type of Completion
 New Well Re-Entry Workover

Oil SWD Temp Abd
 Gas Inj Delayed Comp.
 Dry Other (Core, Water Supply etc.)

OWWO: old well info as follows:

Operator
Well Name
Comp. Date Old Total Depth

WELL HISTORY

Drilling Method: Mud Rotary Air Rotary Cable

5-9-85 5-22-85 8-6-85
plug Date Date Reached TD Completion Date

950
Total Depth PBSD

Amount of Surface Pipe Set and Cemented at 21' 8" feet

Multiple Stage Cementing Collar Used? Yes No

If Yes, Show Depth Set feet

Alternate 2 completion, cement circulated
from feet depth to w/ SX cmt

50' Cement plug T.D.
50' Cement plug 475 to 525
Cement plug 350' to top

API NO. 15-15-205-24,189
County Wilson
CE/25/2 NE Sec 22 Twp 28 Rge 17 East West

3960 Ft North from Southeast Corner of Section
330 Ft West from Southeast Corner of Section
(Note: locate well in section plat below)


Lease Name W. McMillen Well# 2

Field Name Vilas

Producing Formation none

Elevation: Ground KB

Section Plat

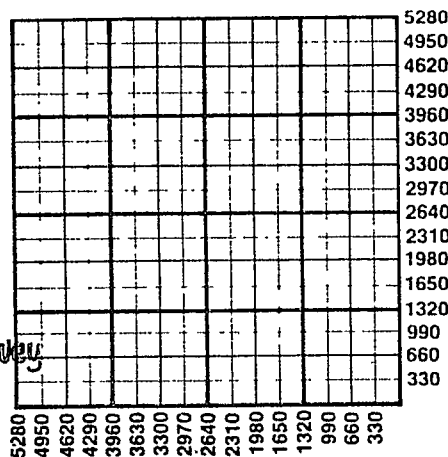

AUG 19 1985

State Geological Survey
WICHITA BRANCH

WATER SUPPLY INFORMATION

Source of Water:
Division of Water Resources Permit #
 Groundwater Ft North From Southeast Corner and Ft. West From Southeast Corner of (Well) Sec Twp Rge East West
 Surface Water Ft North From Southeast Corner and Ft West From Southeast Corner (Stream, Pond etc.) Sec Twp Rge East West
 Other (explain) (purchased from city, R.W.D.#)

Disposition of Produced Water: Disposal Repressuring

Docket #

INSTRUCTIONS: This form shall be completed in duplicate and filed with the Kansas Corporation Commission, 200 Colorado Derby Building, Wichita, Kansas 67202, within 90 days after completion or recompletion of any well. Rules 82-3-130 and 82-3-107 apply.

Information on side two of this form will be held confidential for a period of 12 months if requested in writing and submitted with the form. See rule 82-3-107 or confidentiality in excess of 12 months.

One copy of all wireline logs and drillers time log shall be attached with this form. Submit CP-4 form with all plugged wells. Submit CP-111 form with all temporarily abandoned wells.

Operator Name

W & W Production Co.

Lease Name W. McMillen Well# 2. SEC. 22. TWP. 28. RGE. 17.....

East West

WELL LOG

INSTRUCTIONS: Show important tops and base of formations penetrated. Detail all cores. Report all drill stem tests giving interval tested, time tool open and closed, flowing and shut-in pressures, whether shut-in pressure reached static level, hydrostatic pressures, bottom hole temperature, fluid recovery, and flow rates if gas to surface during test. Attach extra sheet if more space is needed. Attach copy of log.

Drill Stem Tests Taken Yes No
 Samples Sent to Geological Survey Yes No
 Cores Taken Yes No

Formation Description
 Log Sample

4' Clay/soil	0	4
8' Sand stone	4	12
88' Shale	12	100
12' Lime	100	112
35' Sandy shale	112	147
26' Shale	147	173
2' Lime	173	175
40' Shale	175	215
82' Lime	215	297
15' Shale	297	312
100' Lime	312	412
90' Shale	412	502
17' Lime	502	519
83' Shale	519	602
35' Lime	602	637
46' Shale	637	683
20' Lime	683	703
6' Shale/slate	703	709
6' Lime	709	715
3' Shale	715	718
3' Coal	718	721
13' Shale	721	733
1' Sand oil	733	734
184' Shale	734	918
30' Sand	918	948
2' Shale	948	950

Name Top Bottom

CASING RECORD new used

Report all strings set - conductor, surface, intermediate, production, etc.

Purpose of string	size hole drilled	size casing set (in O.D.)	weight lbs/ft.	setting depth	type of cement	# sacks used	type and percent additives
Surface pipe		7"		21' 8"			

PERFORATION RECORD

Acid, Fracture, Shot, Cement Squeeze Record

shots per foot	specify footage of each interval perforated	(amount and kind of material used)	Depth
.....
.....
.....
.....