


Section 27 Township 13 Range 17W

Well No. #1 Geist

Company D. R. Lauck

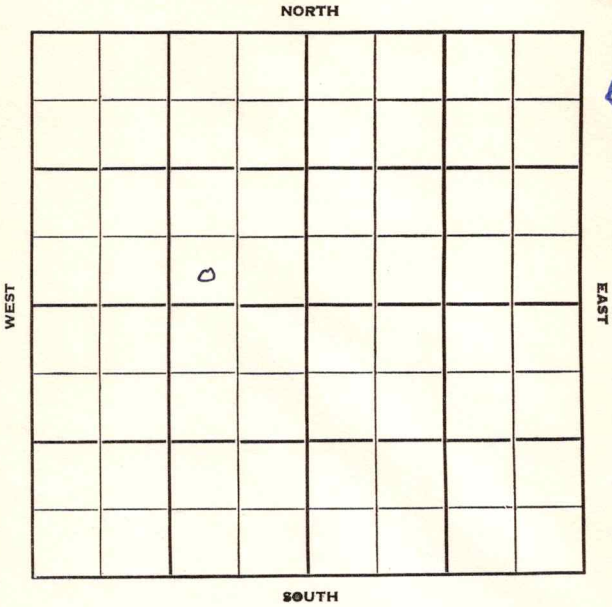

Sec. 27 Twp. 13 R. 17 W ✓

Well No. # 1 Geist Farm

D. R. Lauck Company

Pickeral Contractor

Sugar-Loaf


Ft. from N. Line

330 Ft. from S. Line

990 Ft. from E. Line

Ft. from W. Line

SW SE NW

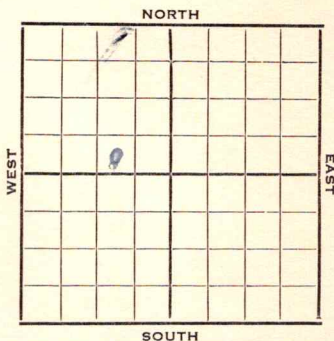

REPORT

1952 **Elv. 1984'**

4/2 Spud 3-26-52  
8" @ 200

**Anhy 1195'**  
Drlg. 2860'

4/9 **Lans. 3284** **Arb. 3531**  
**RTD 3539**

5" @ 3533 WOC  
DST 3533-37, 1/2 hr. 540' oil 20' OCM  
4/23 CO 3537' S/10 BOPH for 3 hrs. POP

4/30 NR

5/7 "

5/14 "

5/21 "

5/28 "

6/4 Spud 3-26-52  
Oil Well TD 3539  
8" @ 200

**Anhy 1195** **Lans. 3284**  
**Arb. 3531** TD 3539  
5" @ 3533

DST 3533-37 opn 1/2 hr. Rec. 540' oil  
20' ocm CO to 3537 S/10 boph  
Comp. 159 bopd

**COMPLETED**



