


Section 27 Township 13 Range 17W

Well No. #4 Giest

Company D.R. Lauck

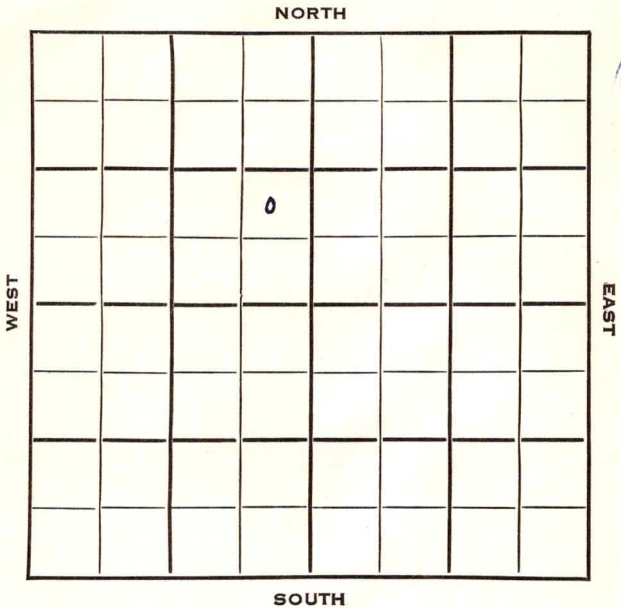

Ellis

KANSAS

SEC.	TWP.	R.
27	13	17W ✓

WELL NO.

#4 Giest

FARM

COMPANY

D.R. Lauck

CONTRACTOR

Younger Pool


NORTH

Ft. from N. Line

Ft. from S. Line

Ft. from E. Line

Ft. from W. Line

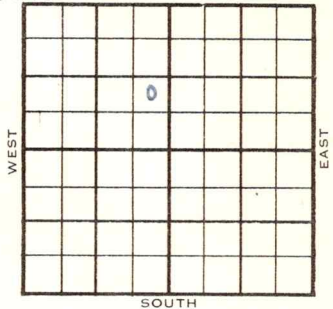

NE SE NW

	ELEVATION	REPORT
1954	1986'	
3/31	Spud 3-27-54 8" @ 160'	
4/7	Drlg 1318' Heeb 3240' Tor 3262 Lans 3286 DST 3342-70, 1/4 hr, 30' M 500# Arb. 3523 RTD 3525'	
5/5	Spud 3-27-54 Oil Well TD 3535' 8" @ 160' Heeb 3240', Tor 3262', Lans 3286' DST 3342'-70' opn 1/4 hr, rec 30' Mud 500# Arb 3523', TD 3525' 5" @ 3523' DD 3531' 3 boph DD 3535' 250 A 4 boph Comp 120 bopd.	

COMPLETED

County Ellis State Kansas
 Sec. 27 (Blk.) 13 (Sur.) 17W Map No.
 Operator D. R. Lauck
 Well No. 4 Farm Giest
 Elev. _____ Location NE SE NW

		0			

FIRST REPORT

990 Ft. From S Line NW
330 Ft. From E Line Quarter
 Ist. Report MAR 31 1954

Completion _____

Remarks _____

Spudding Date 3-27-54

Drlg. Data Younger Pool

8" @ 160 drlg. 1318

County Ellis State Kansas

Sec. 27 (Blk. Twp.) 13 (Sur. Rge.) 17W Map No.

Operator D. R. Lauck

Well No. 4 Farm Giest

Elev.	1986	Location	NE SE NW
-------	------	----------	----------

0

COMPLETE

990 Ft. From S Line NW

330 Ft. From H. Line Quarter

1st. Report

Completion MAY 5 1958

Remarks	Rome Pool
---------	-----------

Spudding Date 3-27-54

Drig. Data Oil well TD 3535

8" @ 160 Heeb. 3240 Tor. 3262

Lans. 3286 DST 3342-70 open $\frac{1}{4}$ hr.

Rec. 30' mud 500# Arb. 3523

TD 3525 5" @ 3523 DD 3531 3 boph

DD 3535 250 A 4 boph

Comp. 120 bopd