

Section 27 Township 13 Range 17W

Well No. #5 Geist

Company D R Lauok & H.H. Blair

NORTH

			0				

3

WEST

EAST

SOUTH

Ellis

KANSAS

SEC.	TWP.	R.
27	13	17W

WELL NO.

COMPANY #5 Geist FARM

CONTRACTOR D.R. Lauck & H. H. Blair


Co. Tools.

990 Ft. from N. Line

Ft. from S. Line

330 Ft. from E. Line

Ft. from W. Line

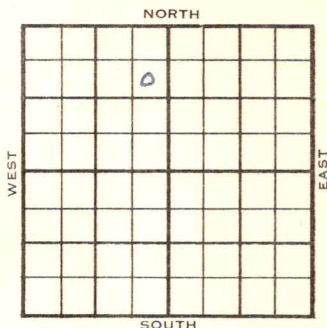

SE NE NW

	ELEVATION	REPORT
1954	1988'	

4/7

M I R

6/9

Spud 4-7-54 Oil well TD 3545'  
 8-5/8" @ 154 Heeb 3248 KC 3294  
 DST 3315-25 open 3/4 hr rec 14' mud  
 830# Arb. 3537 TD 3542 5" @ 3539  
 DD 3545 S/5 BOPH  
 Comp. 155 BOPD

COMPLETED



