


KANSAS

Section 27 Township 13 Range 17W

Well No. #6 Geist

Company D.R. Lauck

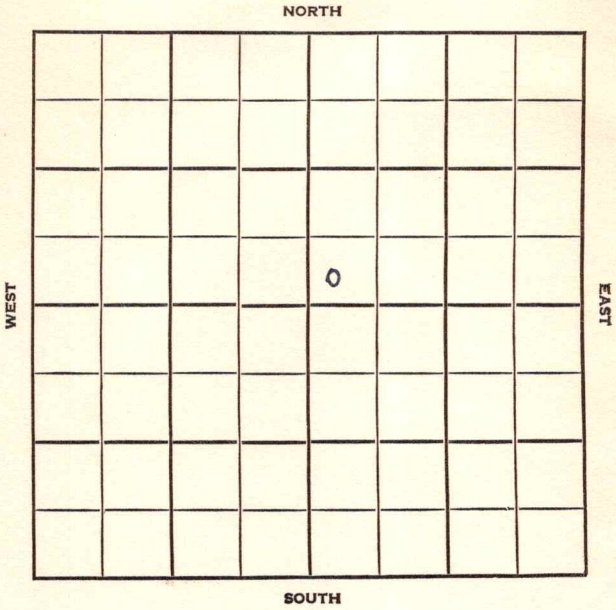

Ellis KANSAS

| | | |
|------|------|-------|
| SEC. | TWP. | R. |
| 27 | 13 | 17W ✓ |


WELL NO. 6 Geist FARM

COMPANY D. R. LAUCK

CONTRACTOR Lauck

Sugarload Poll

_____ Ft. from N. Line
 330 _____ Ft. from S. Line
 _____ Ft. from E. Line
 330 _____ Ft. from W. Line

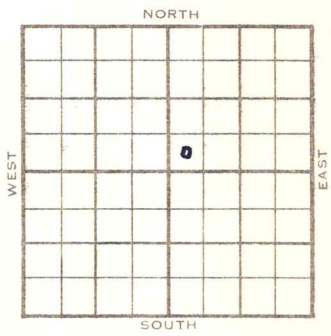

SW SW NE

| | ELEVATION | REPORT |
|--|-----------|--------|
|--|-----------|--------|

1954

1987'

4/27

Spud 4-24-54
 8" @ 132'
 Drlg. 1650'

5/5

DST 3271-3305, 1/2 hr, 130' O & GCM
 880#
 Drlg. 3405'

6/9

Spud 4-24-54 Oil well TD 3510
 8" @ 132' **Tor. 3246** **Lans 3269**
 DST 3271-3305 open 1/2 hr rec 130' O &
 GCM 880#
 DST 3315-68 open 20 min, rec 2040'
 gas, 480' OCM, 540' GCO 940#
Arb. 3507 TD 3510 5" @ 3509
 126/3346-67 1000 A S/15 BOPH
 Comp. 326 BOPD

COMPLETED

County Ellis State Kansas

Sec. 27 (Blk. 13) (Sur. 17W) (Rge.) Map No.

Operator D. R. Lauck

Well No. 6 Farm Geist

Elev. 1987 Location SW SW NE



330 Ft. From S Line NE

330 Ft. From W Line Quarter

1st. Report

Completion JUN 9 1954

Remarks Sugarloaf Pool
Lauck - Contr.

Spudding Date 4-24-54

Drlg. Data Oil well TD 3510

8" @ 132 Tor. 3246 Lans. 3269

DST 3271-3305 open 1/2 hr. Rec. 130' o &

gcm 880# DST 3315-68 open 20 min.

Rec. 2040' gas 480' ocm 540' gco

940# Arb. 3507 TD 3510 5" @ 3509

126/ 3346-67 1000 A S/ 15 boph

Comp. 326 bopd