

Ellis KANSAS

SEC. 27 TWP. 13 R. 17W ✓

WELL NO.

7 Geist

FARM

COMPANY

D. R. Lauck & H. H. Blair

CONTRACTOR

Co. Tools


Wheatland Pool

990 Ft. from N. Line

Ft. from S. Line

Ft. from E. Line

330 Ft. from W. Line

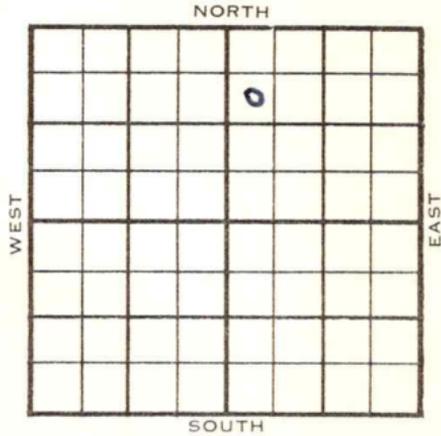

SW NW NE

1954 ELEVATION 1990' REPORT

5/12

Spud 5-7-54
10" @ 125'
Anhy 1200'
Drig. 2600'

5/19

Heeb 3252 Tor 3270 Lans 3296
DST 3368-92, 1 hr, 90' SOCM 960#
Arb. 3539 RTD 3541 5" @ 3540

5/26

WOCT

6/2

CO 3541 S/3 BOPH POP

6/9

NR

6/30

"

7/7

"

7/14

Spud 5-7-54 Oil well TD 3541
10" @ 125' Anhy 1200 Heeb 3252
Tor. 3270 Lans 3296
DST 3368-92 open 1 hr rec 90' SOCM
960# Arb. 3539 TD 3541 5" @ 3540
CO to 3541 S/3 BOPH
Comp. 107 BOPD

COMPLETED


County Ellis State Kansas

Sec. 27 (^{Blk.}Twp.) 13 (^{Sur.}Rge.) 17W Map No.

Operator D. R. Lauok & H. H. Blair

Well No. 7 Farm Geist

Elev. 1990 Location SW NW NE

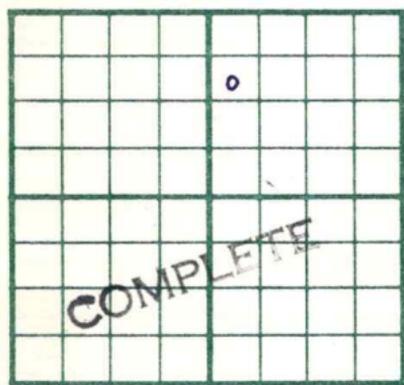

990 Ft. From N Line NE

330 Ft. From W Line Quarter

Ist. Report

Completion JUL 14 1954

Remarks Wheatland Pool

Co. tools

Spudding Date 5-7-54

Drlg. Data Oil well TD 3541

10" @ 125 Anhy 1200 Heeb. 3252

Tor. 3270 Lans. 3296 DST 3368-92

open 1 hr. Rec. 90' socm 960#

Arb. 3539 TD 3541 5" @ 3540 CO to 3541

S/ 3 boph Comp. 107 bopd