


Section 27 Township 13 Range 17W

Well No. 3 Anna Weber

Company Gulf Oil

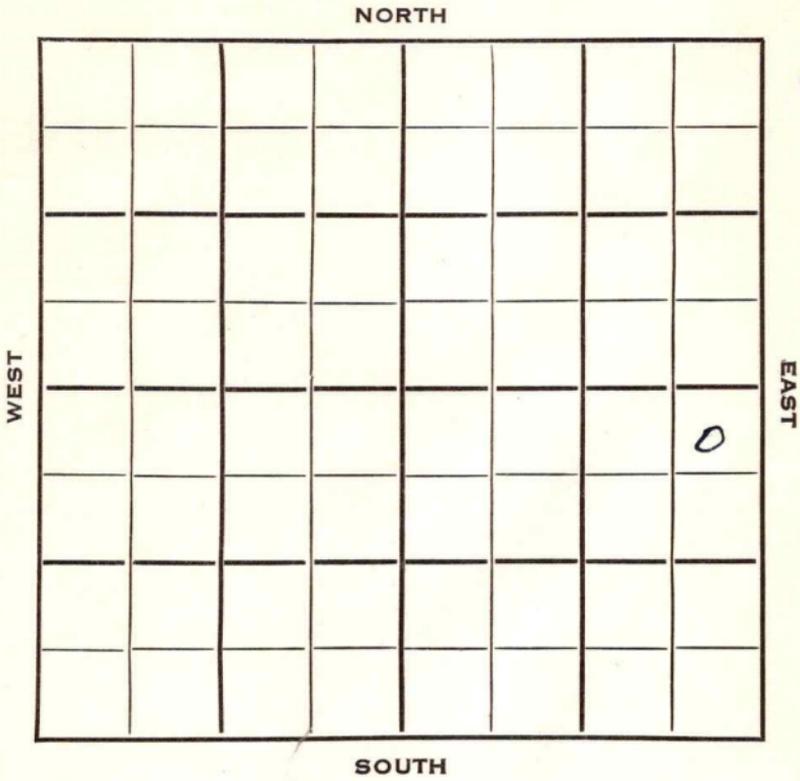



Sec. 27 Twp. 13 R. 17 W

Well No. # 3 Anna Weber Farm

Gulf Oil Company

Rome Pool Contractor


330 Ft. from N. Line

Ft. from S. Line

330 Ft. from E. Line

Ft. from W. Line

NE NE SE

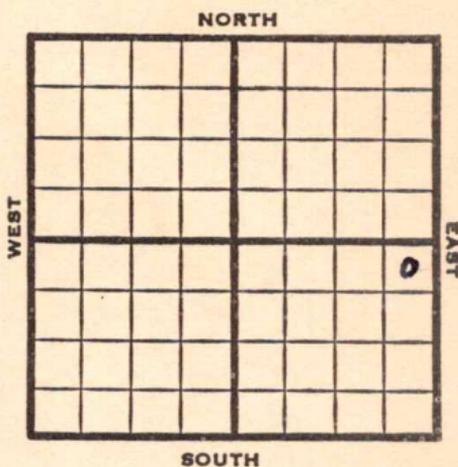

1952 Elev. 1986' REPORT

12/10 Location

12/11 "

12/18 "

12/25 8" @ 1098

1/1 Heeb 3225 Tor 3244 Lans 3273

Arb 3515 RTD 3517 5" @ 3516

1/8 CO 3517 FU 2000' Oil 3 Hrs. DD 3519

s/123 BO 5 Hrs. 500A S/86 BO 3 Hrs.

DD 3523 S/163 BO 5 Hrs. DD 3527 TD

s/162 BO 5 Hrs. POP

1/22 NR

1/29 "

2/5 NR

2/11 Spud 12-13-52

Oil Well

TD 3527

8" @ 1098

Heeb 3225, Tor 3244, Lans 3273, Arb 3515

TD 3517

5" @ 3516, CO to 3517, FU 2000' oil, 3 hrs., DD 3519, S/123 bo

5 hrs., 500A, S/86 bo 3 hrs.,

DD 3523, S/163 bo 5 hrs., DD

3527, S/162 bo 5 hrs.

Comp. 1748 bopd **COMPLETED**

