


Ellis

KANSAS

SECTION 27 TOWNSHIP 13 RANGE 17 W

WELL NO. #9 Geist

COMPANY D. R. Lauck

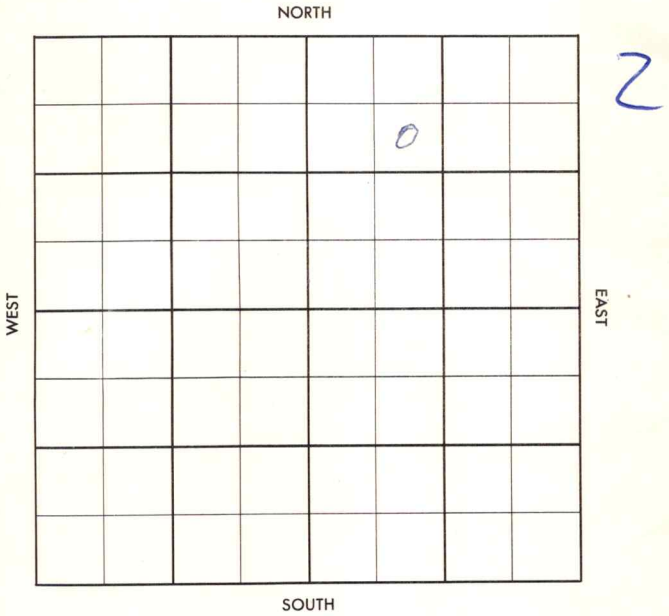

Ellis

KANSAS


SEC.	TWP.	R.
27	13 <del>E</del> <del>S</del>	17W

WELL NO. #9 Geist FARM

COMPANY D. R. Lauck

CONTRACTOR Todd Drlg  
SE Sugarloaf

\_\_\_\_\_ Ft. from N. Line  
 \_\_\_\_\_ Ft. from S. Line  
 \_\_\_\_\_ Ft. from E. Line  
 \_\_\_\_\_ Ft. from W. Line

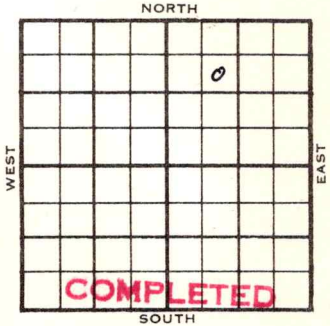

SE NW NE

	ELEVATION	REPORT
--	-----------	--------

1955

11/6

Comm 11-14-55  
 8" @ 140  
 WOC

County Ellis Elev. \_\_\_\_\_  
 Sec. 27 Twp. 13 Rge. 17W  
 Company D. R. Lauck  
 Farm Name Geist No. 9

TOPS	DEPTH	LOG	DATUM	Loc. in Sec.
Anh.				SE NW NE
Tp.				
H.				
Tr.				
Dg.				
B.L.				
L.				
K.C.				Geol. _____
B.K.C.				Contr. _____
Ce.				Todd Drlg.
C.				
M.				Pool _____
M.				SE Sugarloaf
K.				
Mz.				
Ma.				
V.				
S.				
S.				
A.				
R.				
Pe.				
G.				
T.D.				

FIRST REPORT

Date Comm. 11-14-55  
8" @ 140 WOC

NOV 19 1955

NOV 16 1955

14

Co.  
Lse.  
No.  
Sec.  
T.  
R.

27

County Ellis Elev. 1992  
 Sec. 27 Twp. 13 Rge. 17W  
 Company D. R. Lauck  
 Farm Name Geist No. 9

TOPS	DEPTH	LOG	DATUM	Loc. in Sec.		
Ans.	1215			SE NW NE		
Tp.						
H.	3259					
Tr.						
Dg.						
Bl.						
L.	3304		1.312	Geol.		
K.C.				Contr.		
B.K.C.				Todd Drlg.		
Ce.				Pool		
C.				SE Sugarloaf		
M.				<table border="1" style="width: 100%; height: 100%;"> <tr> <td style="text-align: center;">0</td> </tr> <tr> <td style="text-align: center; font-weight: bold;">COMPLETE</td> </tr> </table>	0	COMPLETE
0						
COMPLETE						
M.						
K.						
Ms.						
Ms.						
V.						
S.						
S.						
A.	3551		1.559			
R.						
PC.						
Q.						
TD	3635	<del>3570</del>	<del>1.559</del>			

Date Comm. 11-14-55 MAR 7 1956  
8" @ 140 WOC NOV 23 '55 DST 3314  
-44 lhr acc. 60' WM  
BHP 710/20 @ 349.3 NOV 30 '55  
DST 3553-74 lhr acc. 10'  
Md BHP 710 5 1/2 DEC 7 '55 DST  
(5t PK) 3562-90 acc. lhr acc.  
20' Md (spkd w/oil) BHP 195/20"  
RTD 3635 5 1/2 @ 3634/100 acc.  
MIC T CO 52/3570-83 7st 2

Goph no wtr no time 1/2 no inc  
A tst 1/2 Boph no wtr 10  
hrs.

DEC 14 '55

Pat.

DEC 21 '55

DEC 28 '55

~~go to ...~~  
WO ST Pat. JAN = '56 X WO

State Pat. JAN 11 '56 JAN 18 '56 ✓ JAN 25 '56 ✓

FEB 1 '56

FEB 8 '56

FEB 15 '56

FEB 22 '56 ✓

FEB 29 '56 ✓

MAR 7 '56

Ph P. 32 B0

+ 43 to wtr

gran 36°

R.G.

MAR 19 1956

721905