


Section 27 Township 13 Range 17W

Well No. #10 Geist

Company D. R. Lauck

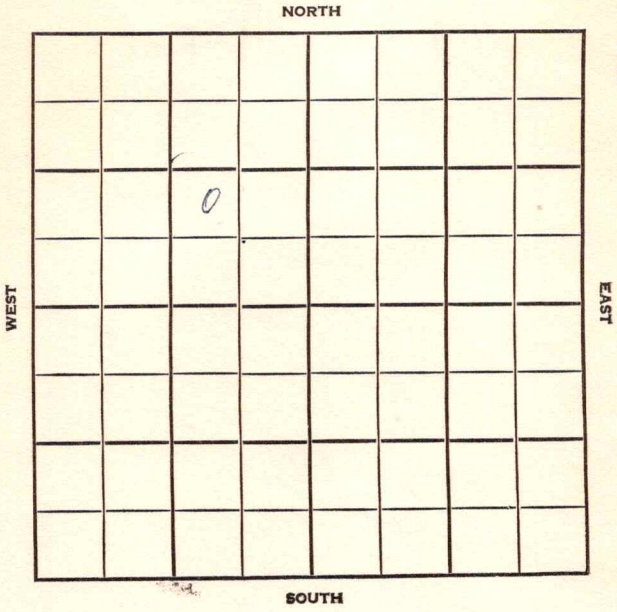

SEC. 27	TWP. 13	R. 17W
------------	------------	-----------

WELL NO. #10 Geist FARM

COMPANY D.R. Lauck

CONTRACTOR Todd Drlg.


SE Sugarloaf

_____ FT. FROM N. LINE

_____ FT. FROM S. LINE

_____ FT. FROM E. LINE

_____ FT. FROM W. LINE

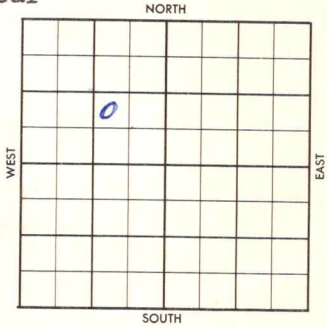

NW SE NW

1956	ELEVATION 1986	REPORT
------	-------------------	--------

6-6 Comm. 5-31-56
10" @ 195
Drlg. 2268'
Anh. 1205'

7-3 DST 3300-30 op 60 min, rec. 10' mud,
BHP 0#.
DST 3373-3402 op 60 min, rec. 6' SOCM,
BHP 570/20".
7 1/2" @ 3855
DD 3930
Input 33 bwph
Comp. for SWD Well
H. 3250', L. 3295', G. 3535', A. 3675'
TD 3872'

ABANDONED

County Ellis Elev. 1986
 Sec. 27 Twp. 13 Rge. 17W
 Company D. R. Lauck
 FarmName Ceist No. 10

TOPS	DEPTH	LOG	DATUM
Anh.	1205		
TP.			
H.			
Tr.			
Dg.			
Bl.			
L.			
K.C.			
B.K.C.			
Ce.			
C.			
M.			
M.			
K.			
Mz.			
Me.			
V.			
S.			
S.			
A.			
R.			
PE.			
G.			
T.D.			

Loc. in Sec. NW SE NW

Geol. _____
 Contr. Todd Drlg.

Pool SE Sugarloaf



Date Comm. 5-31-56
10" @ 195 drlg. 2268

JUN 1 1956

R.G.

Co.
 Lse.
 No.
 Sec.
 T.
 R.

14

County Ellis Elev. 1986
 Sec. 27 Twp. 13 Rge. 17W
 Company D. B. Lauck
 Farm Name Geist No. 10

TOPS	DEPTH	LOG	DATUM	Loc. in Sec.
Anh.	1205			NW SE NW
Tp.				
H.	3250			
Tr.				
Dg.				
Bl.				
L.	3295			Geol.
K.C.				Contr.
B.K.C.				Todd Drlg.
Ce.				
C.	3535			
M.				Pool
M.				SE Sugarloaf
K.				
Mz.				
Mo.				
V.				
S.				
S.				
A	3675			
R.				
PE.				ABANDONED
G.				
T.D.	3872			

Date Comm. 5-31-56 JUL 3 1956

10" @ 195 drlg. 2268 JUN 13 '56

PS 3300-30 (60) 10' M BHP 0

PS 3373-3402 (60) 6' BOCM BHP 570 (20)

#3455 JUN 20 '56 7 1/2 @ 3855 (SW DW)

JUN 27 '56 DD 3930 input 33 BHP

JUL 3 '56 (3) comp. for SWP well