


Ellis **KANSAS**
13 Range 17W

Section 27 Township _____

Well No. 2 Rome

Company Murfin Drlg.

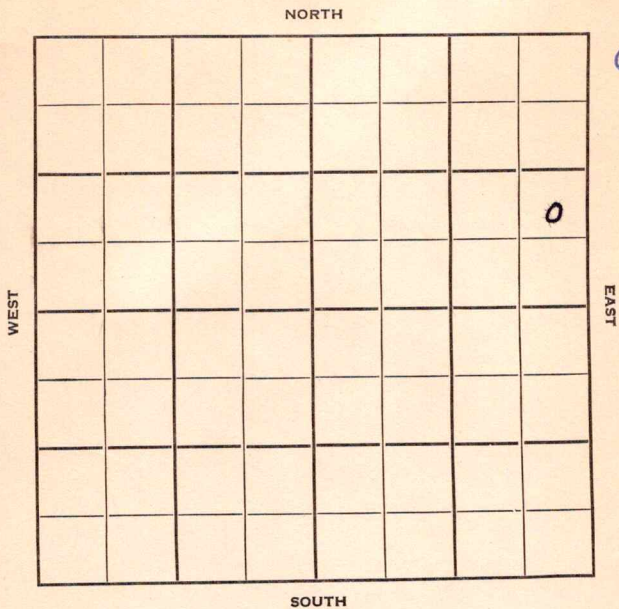

Sec. 27 Twp. 13 R. 17 W

Well No. # 2 Rome Farm

Murfin Drlg. Company

Murfin Drlg. Contractor

Rome Pool


Ft. from N. Line

990 Ft. from S. Line

330 Ft. from E. Line

Ft. from W. Line

NE SE NE

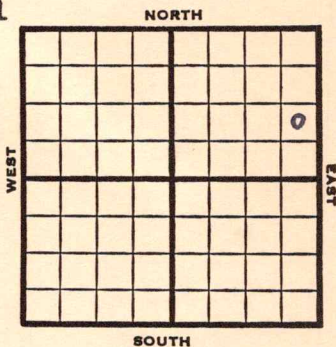

1952

Elv. 1987'

REPORT

12/17

Spud 12-12-52

8" @ 125 Anhy 1199'

Drlg. 2285'

12/25 Drlg 2285

1953

1/7 Spud 12-12-52 D & A TD 3570'

8" @ 125 Anhy 1199' Lans. 3283'

Cong. 3538' TD 3570'

D & A

ABANDONED

County **Ellis** State **Kansas**

Sec. **27** (Blk. Twp.) **13** (Sur. Rge.) **17W** Map No.

Operator **Murfin Drlg.**

Well No. **2** Farm **Rome**

Elev. Location **NE SE NE**

| | | | | | | | |
|--------------|--|--|--|--|--|--|---|
| | | | | | | | |
| | | | | | | | |
| | | | | | | | 0 |
| | | | | | | | |
| FIRST REPORT | | | | | | | |
| | | | | | | | |
| | | | | | | | |

990 Ft. From **S** Line **NE**

330 Ft. From **E** Line Quarter

Ist. Report **DEC 17 1952**

Completion

Remarks

Murfin Drlg. - Contr.

Spudding Date **12-12-52**

Drlg. Data **Rome Pool**

8" @ 125 Anhy 1199 drlg. 2285

J. G. McGEHEE

County Ellis State Kansas

Sec. 27 (Blk. 13) (Sur. 17W) (Twp.) Map No.

Operator Murfin Drlg.

Well No. 2 Farm Rome

Elev. 1987 Location NE SE NE

| | | | | | |
|--|--|--|--|--|---|
| | | | | | |
| | | | | | |
| | | | | | |
| | | | | | 0 |
| | | | | | |
| | | | | | |
| | | | | | |
| | | | | | |
| | | | | | |
| | | | | | |

990 Ft. From S Line NE

330 Ft. From E Line Quarter

Ist. Report

Completion JAN 7 1953

Remarks Rome Pool

Murfin Drlg. - Contr.

Spudding Date 12-12-52

Drlg. Data D & A TD 3570

8" @ 125 Anhy 1199 Lans. 3283

Cong. 3538 TD 3570

D & A