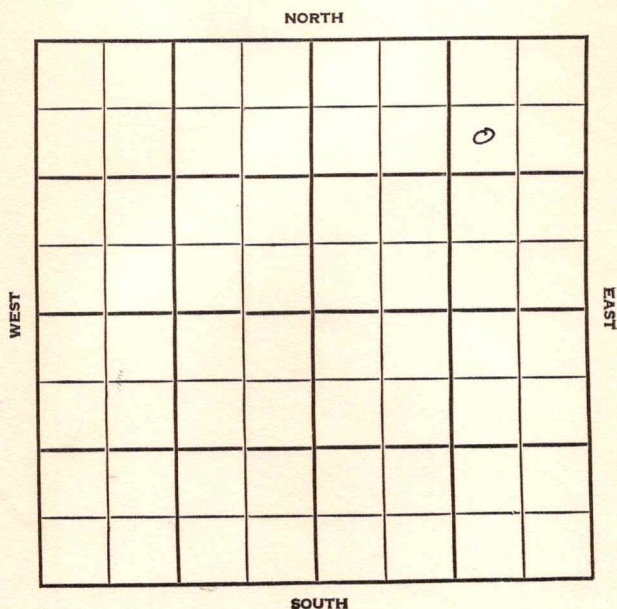


Section 27 Township 13 Range 17 WWell No. #6 RomeCompany Murfin Drlg.

Ellis

KANSAS

SEC.	TWP.	R.
27	13	17W

WELL NO.

#6 Rome

FARM

COMPANY

Murfin Drlg.

CONTRACTOR

Co. Tools


Sugarloaf SE

_____ Ft. from N. Line

_____ Ft. from S. Line

_____ Ft. from E. Line

_____ Ft. from W. Line

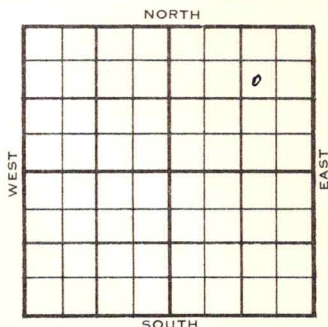

SW NE NE

	ELEVATION	REPORT
1955	1991'	
8/31	Comm 8-26-55 8" @ 125 Drlg 2269 Anh 1210	
11-23	DST 3554-65 op 1 hr. rec. 120' vho&gcm 150' oil, 855# 5½" @ 3557 CO to 3568 FU 900' fluid 12hrs., 1000 A S/ 4 boph 2 hrs. Comp. 157 bopd H. 3251 L. 3300 A 3535 TD 3568'	

COMPLETED

County Ellis Elev. _____
Sec. 27 Twp. 13 Rge. 17W
Company Murfin Dyle
Farm Name Rome No. 6

TOPS	DEPTH	LOG	DATUM
Anh.	1210		
TP.			
H.			
Tr.			
Dg.			
Bl.			
L.			
K.C.			
B.K.C.			
Ce.			
C.			
M.			
M.			
K.			
Mz.			
Mq.			
V.			
S.			
S.			
A.			
R.			
Pf.			
G.			
T.D.			

Loc. in Sec. SW NE NE
Geol. _____
Contr. _____
Co. tools _____
Pool _____
Sugarloaf SE



Date Comm. 8-26-55
8" @ 125 drlg. 2269

14

Co.
Lse.
No.
Sec.
T.
R.

County Ellis Elev. 1991
 Sec. 27 Twp. 13 Rge. 17W
 Company Murfin Drilling
 Farm Name Rome No. 6

TOPS	DEPTH	LOG	DATUM	Loc. in Sec.
Anh.	<u>1210</u>			<u>SW NE NE</u>
Tr.				
H.	<u>3251</u>		<u>1260</u>	
Tr.				
Dg.				
B.L.				
L.	<u>3300</u>		<u>1390</u>	Geol.
K.C.				Contr.
B.K.C.				Co. tools
Ce.				Pool
C.				SE Sugarloaf
M.				
M.				
K.				
Mz.				
Ma.				
V.				
S.				
S.				
A.	<u>3535</u>		<u>1544</u>	
R.				
Pe.				
G.				
T.D.	<u>3568</u>			

Date Comm. 8-26-55 NOV 23 1955

8" @ 125 DST 3554-65 open 1 hr.
 rec. 120' who & gcm 150' oil 855#
 5 $\frac{1}{2}$ " @ 3557 CO to 3568 FU 900' fluid
 12 hr. 1000 A S/ 4 boph 2 hr.
 Comp. 157 bopd