

Ellis

KANSAS

Sec. 27 Twp. 13 R. 17W

Well No. #1 Weber Farm

Harms & Knight et al Company

SE Sugar Loaf Pool Contractor


990 Ft. from N. Line

Ft. from S. Line

Ft. from E. Line

330 Ft. from W. Line

SW NW SW
Gulf farmout

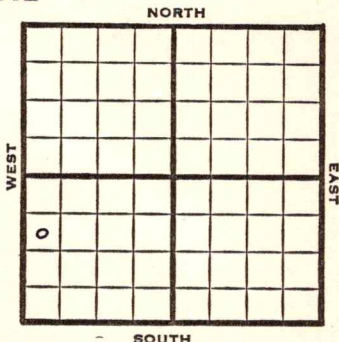

1952

ELEV. 1969' REPORT

10/1 Location

10/8

8" @ 116
Anhy 1166
Drlg. 2210'

10/15

Heeb 3201, Lans 3243
DST 3263-3330 1 hr., 60' HOCM
Drlg. 3396'

10/22

Arb. 3490
RTD 3495
5" @ 3492'

10/29

CO 3495' S/3 1/2 BOPH 3 hrs. DD 3512'
TD. 250 A S/4 BOPH

11/5

NR

11/12

"

11/20

"

11/27

"

12/4

NR

12/11

NR

12/17

Spud 10-1-52
Oil Well
TD 3512'
8" @ 116
Anhy 1166, Heeb 3201, Lans 3243
DST 3263-3330, opn 1 hr., rec.

OVER

721940

(Information Brought Forward)

1952

12/17 60' hocm, 150' ocm, 675#

Arb. 3490

TD 3495

5" @ 3492

CO to 3495

S/3 $\frac{1}{2}$ boph DD 3512 250A

S/4 boph

Comp. 351 bopd

COMPLETED

