

Section 27 Township 13 Range 17W

Well No. #2 Weber

Company Gulf Oil

NORTH

			0				

WEST

EAST

SOUTH

11

Ellis

KANSAS ✓

Sec. 27 Twp. 13 R. 17W

Well No. #2 Weber Farm

Gulf Oil Company

Peel Drlg. - Contr. Contractor


330' Ft. from N. Line

_____ Ft. from S. Line

330' Ft. from E. Line

_____ Ft. from W. Line

NE NE SW

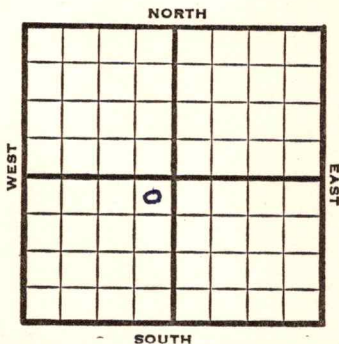

1952

Elev. 1985' REPORT

7/9

Spud 7-2-52
8" @210

Anhy 1195

Drlg. 2520'

7/16

Spud 7-2-52

D & A TD 3615' 8" @ 210

Anhy 1195' Heeb 3252' Tor. 3274'

Lans. 3296'

DST 3450-90 open 1 hr. rec 13' mud Off

Cong. 3542' Arb. 3599' TD 3615'

D & A

ABANDONED

