


Section 27 Township 13 Range 17 W

Well No. # 2 Weber

Company Harms & Knight

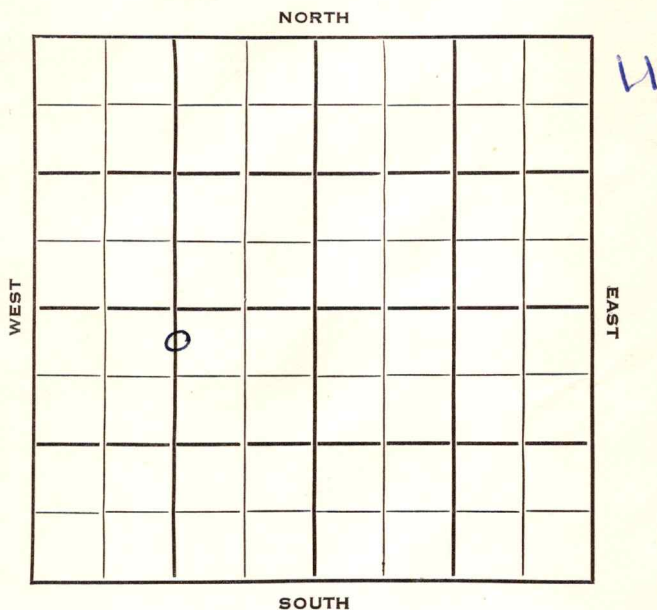

Ellis KANSAS

SEC. 27 TWP. 13 R. 17W ✓

WELL NO. 2 Weber FARM

COMPANY Harms & Knight

CONTRACTOR Harms & Burt

330 SE Sugarloaf Pool


~~990~~ Ft. from N. Line

Ft. from S. Line

Ft. from E. Line

1320
~~330~~ Ft. from W. Line

C N/2 N/2 SW
~~SW NW SW~~

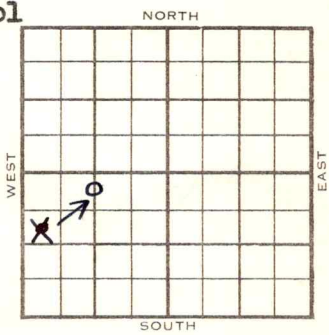

	ELEVATION	REPORT
1954	1980'	

6/23 Spdg. 6-21-54
7/7 Heeb 3245', Lans 3290', Arb. 3533'
DST 3528-37', 1 hr., 840' gas, 400' GCO
TD 3541'
5" @ 3539'

8/18 Spud 6-21-54 - Oil Well
TD 3541'
8" @ 125'
Heeb 3245', Lans 3290', Arb. 3533'
DST 3528-37', opn 1 hr., rec. 840' gas, 400' gco,
TD 3541'
5" @ 3539'
CO to 3541' 4 boph
Comp. 68 bopd

COMPLETED

Joe,

Harms drilled a #1 here in this spot in late '52.....

Wotta we do?

Luville

JUN 24 1954

Scout Cards	<i>DM</i>
Land Small Map	
Land Wall Map	<i>3</i>
Tracings	
France Map	
Pierce Map	
Misc.	

Orig. Data