


Section 27 Township 13 Range 17W

Well No. #8 Weber

Company Gulf Oil

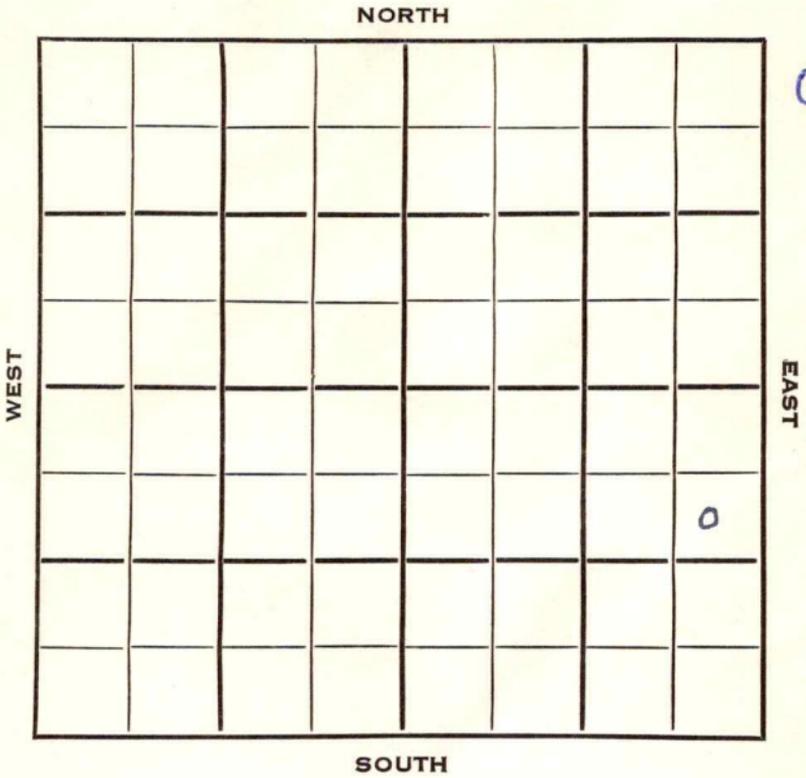


SEC.	TWP.	R.
27	13	17W ✓

WELL NO. 8 Weber FARM

COMPANY Gulf Oil

CONTRACTOR Anschutz Drlg.

Rome Pool
 990 Ft. from N. Line
 Ft. from S. Line
 550 Ft. from E. Line
 Ft. from W. Line

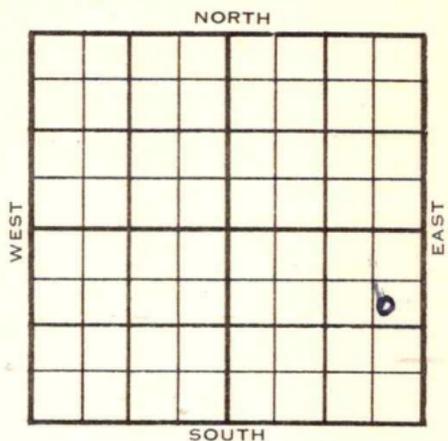

SE NE SE

1954	ELEVATION 1985'	REPORT
------	--------------------	--------

3/10
3/17

MIR
 Anhy 1180' 8" @ 1186
 Tarkio 2739 Top 2975 Tor 3239
 Lans. 3269

DST 3276-99, 3/4 hr, 682' SOCM
 880#
 DST 3330-68, 1 hr, 31' M 6' hly OCM
 550#
 DST 3430-67, 1/2 hr, 15' M 555#
 Drlg. 3467'

4/28

Spud 3-6-54
 Oil Well
 TD 3519'
 Anhy 1180'
 8" @ 1186'
 Tarkio 2739', Top 2975', Tor 3239',
 Lans 3269'
 DST 3276-99', opn 3/4 hrs., rec. 682',
 socm, 880#
 DST 3330-68', opn 1 hr., rec. 31' mud,
 6' hocm, 550#
 DST 3430-67', opn 1/2 hrs., rec. 15'
 mud, 555#
 Arb. 3509'
 TD 3514'

OVER

721947

(Information Brought Forward)

1954
4/28

5" @ 3511'
CO to 3477'
20/3399-3404', 28/3349-56
B/7 gwph, 16/3316-20, B/19 gwph
16/3293-3302', B/27 gwph
S/15 bw 15 hrs., 1000A
S/24 bw
CO to 3517'
S/1½ boph 2 hrs.,
DD 3519'
S/3 boph 4 hrs.
Sd-oil-frac
S/3 bo 5 hrs.
Comp. 256 bopd

COMPLETED

