


DX 78-1

Section 27 Township 13 Range 17W

Well No. 9 Weber


Company Gulf Oil

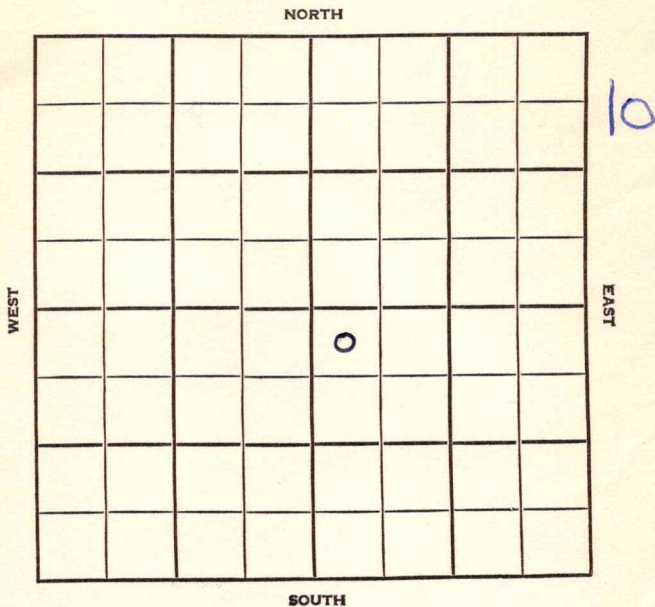

Ellis KANSAS

SEC.	27	TWP.	13	R.	17W ✓
WELL NO.	9 Weber				(Anna B.)
COMPANY	Gulf Oil				FARM
CONTRACTOR	Anschutz - Contr.				
	Rome Pool				

330 _____ Ft. from N. Line
 _____ Ft. from S. Line
 _____ Ft. from E. Line
 330 _____ Ft. from W. Line

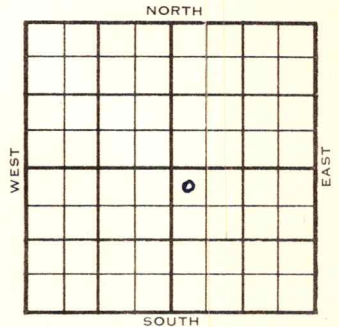

NW NW SE

1954	ELEVATION	REPORT
	1984	
6/30	Spudding 6-20-54 8" @ 1190 Anhy 1185 Heeb 3227 Tor. 3247 Lans 3272 DST 3276-3303 open 1 hr. Rec. 432' sgcsw 800# drlg. 3300	
7/21	Spdg 6-20-54 D&A TD 3710 Anhy 1185 8" @ 1190 Heeb 3227 Tor. 3247 Lans. 3272 DST 3276-3303 open 1 hr. Rec. 432'. sgcsw 800# DST 3315-75 open 1 hr. Rec. 580' sw 700# DST 3432-80 open 1 hr. Rec. 65' sw 1095# Cong. 3513 Arb. 3687 DST 3690-3710 open 1 hr. Rec. 600' sw 270# TD 3710 D&A	

ABANDONED

County **Ellis** State **Kansas**

Sec. **27** (Blk. **13**) (Sur. **17W**) (Twp.) (Rge.) Map No.

Operator **Gulf Oil**

Well No. **9** Farm **Weber**

Elev. **1984** Location **NW NW SE**

FIRST REPORT

330 Ft. From **N** Line **SE**
330 Ft. From **W** Line Quarter

Ist. Report **JUN 30 1954**

Completion

Remarks

Anschutz - Contr.

Spudding Date **6-20-54**

Drlg. Data **Rome Pool**

Anhy 1185 8" @ 1190 Heeb. 3227

Tor. 3247 Lans. 3272 DST 3276-3303

open 1 hr. Rec. 432' sgcsw 800#

drlg. 3300

County Ellis State Kansas

Sec. 27 (Blk. 13) (Sur. 17W) Map No.

Operator Gulf Oil

Well No. 9 Farm Weber

Elev. 1984 Location NW NW SE



330 Ft. From N Line SE

330 Ft. From W Line Quarter

1st. Report

Completion JUL 21 1954

Remarks Rome Pool

Anschutz - Contr.

Spudding Date 6-20-54

Drlg. Data D & A TD 3710

Anhy 1185 8" @ 1190 Heeb. 3227

Tor. 3247 Lans. 3272 DST 3276-3303

open 1 hr. Rec. 432' sgcsw 800#

DST 3315-75 open 1 hr. Rec. 580' sw

700# DST 3432-80 open 1 hr. Rec.

65' sw 1095# Cong. 3513 Arb. 3687

DST 3690-3710 open 1 hr. Rec. 600' sw

270# TD 3710

D & A

O. W. D. D. X

Twp. Pool

S-513-B

Geol. Facet

County Ellis Elev 1984
 Sec. 27 Twp. 13 Rge. 17W
 Company Gulf Oil Corp.
 Farm Name Weber No. 9

TOPS	DEPTH	LOG	DATUM
Anh.			
Tp.			
H.	3226		
Tr.	3246		
Dg.			
B.L.			
L.	3271		
K.C.			
B.K.C.	3513		
Ce.			
C.			
M.			
M.			
K.			
Mz.			
Mq.			
V.			
S.			
S.			
A.	3687		
R.			
Pf.			
G.			
OTD	3710		
T.D.			

Loc. in Sec.

NW NW SE

(O.W.D.D. for S.W.D.W.)

Geol.

Contr.

Pool

Sugar Loaf

FIRST REPORT
 JUN 25 '58
 ABANDONED

Date Comm.

OLD INFO: Tops, was D & A.

NEW INFO: MIRT DD 3953, 5" @ 3739 w/100,
CO 3953, Swb 85 BWP 3 hrs, 1200' OB, Swb
500 BW 8 hrs, Injection test: 200 BW 1 hr,

COMPLETE SWDW