


Section 27 Township 13 Range 17 W

Well No. # 5 Weber

Company Gulf Oil

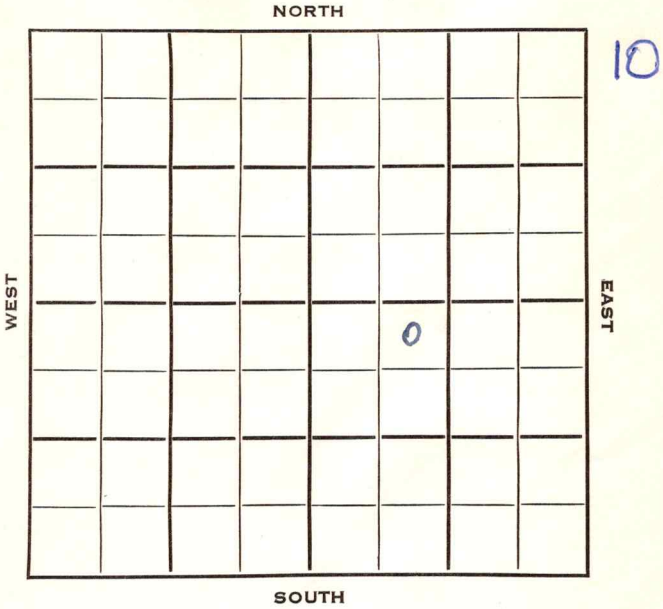

Ellis

SEC.	TWP.	R.
27	13	KANSAS 17W ✓

WELL NO.

#5 Weber

FARM

COMPANY

Gulf Oil

CONTRACTOR

Rome Pool

330


Ft. from N. Line

Ft. from S. Line

Ft. from E. Line

990

Ft. from W. Line

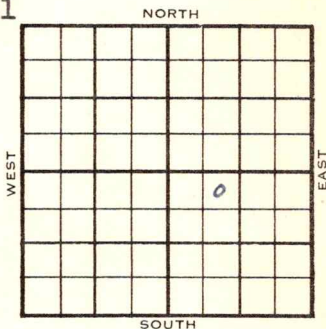

NE NW SE

ELEVATION

REPORT

1953

1985'

11/18

Location

~~XXIX~~

1954

1/20

Spud 11-27-53 Oil well TD 3503
 Anhy 1189 8" @ 1198 Heeb 3212
 Tor. 3233 Lans. 3257
 DST 3242-88 open 1 hr rec 1000' gas,
 30' mud, 660' VHO & GCM 945#
 DST 3310-60 open 1 hr rec 960' free oil
 580' VHO & GCM 975#
 DST 3408-57 open 3/4 hr rec 30' SO
 & GCM Arb. 3498 TD 3501
 5" @ 3500 CO to 3501 FU 600' oil
 1/2 hr, FU 1800' oil 2 hr. DD 3503
 S/75 BO 3 hr. 500 A S/122 BO 4 hr.
 Comp. 1380 BOPD

COMPLETED

County

Ellis

State

Kansas

Sec.

27

(Blk.)
(Twp.)

13

(Sur.)
(Rge.)

17W

Map No.

Operator

Gulf Oil

Well No.

5

Farm

Weber

Elev.

Location

NE NW SE

FIRST REPORT

330

Ft. From

N Line

SE

990

Ft. From

IV Line

Quarter

1st. Report

NOV 18 1953

Completion

Remarks

Spudding Date

Drig. Data

Rome Pool

Location

County Ellis State Kansas
 Sec. 27 (Blk.) 13 (Sur.) 17W Map No. _____
 Operator Gulf Oil
 Well No. 5 Farm Weber
 Elev. 1985 Location NE NW SE



330 Ft. From N Line SE
990 Ft. From W Line Quarter

1st. Report

Completion JAN 20 1954

Remarks Rome Pool

Spudding Date 11-27-53

Drlg. Data Oil well TD 3503

Anhy 1189 8" @ 1198 Heeb. 3212

Tor. 3233 Lans. 3257 DST 3242-88

open 1 hr. Rec. 1000' gas 30' mud

660' vho & gcm 945# DST 3310-60

open 1 hr. Rec. 960' free oil 580'

vho & gcm 975# DST 3408-57 open 3/4 hr.

Rec. 30' so & gcm Arb. 3498 TD 3501

5" @ 3500 CO to 3501 FU 600' oil 1/2 hr.

FU 1800' oil 2 hr. DD 3503 S/ 75 bo

3 hr. 500 A S/ 122 bo 4 hr.

Comp. 1380 bopd

J. G. McGEHEE