

**GEOLOGICAL DEPARTMENT
UNION GAS CORPORATION
INDEPENDENCE, KANSAS**

FL.

Company Union Gas Corporation

S. T. R. 27-28-17
County Wilson
State Kansas
Lease and Well No. J. Ogden #2

Contractor Archie Newland


Drilling Commenced May 29, 1928 Drilling Completed June 8, 1928

Initial Production 107,000 cu. ft.

Initial Rock Pressure

Location 440' W. and 660' N. of SE corner of Section

Casing 8 1/4" 50' 9"

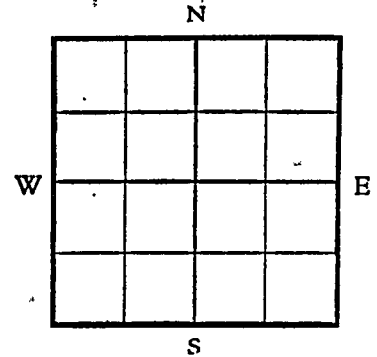

Driller's Record of Formations

3	soil	3	5	sand dark dry	793
9	yellow mud	12	14	shale darl	807
12	shale	24	33	shale dark little	
6	lime	30		water	840
10	shale	40	7	sand	847
2	lime	42			
88	shale	130		When completed had	
2	sand	132	little gas	shallow gas sand	70 M.
68	lime	200		Oswego gas	37 M
3	shale dark little				
	water	203			
4	lime	207			
36	shale	243			
25	lime	268			
7	black slate	275	H.F.W.		
45	lime	320			
55	shale dark	375			
5	lime	380			
10	shale	390			
10	lime	400			
25	shale	425			
10	lime	455			
12	shale	447	S.L.M.		
10	sand gas 65,000	457			
68	shale	525			
7	lime	532			
2	black shale	534			
29	lime	563			
39	shale	604	S.L.M.		
21	lime	625			
8	black shale	633	gas tested 11,000		
5	lime	638			
6	black shale	644	gas tested 16,000		
18	shale white	662			
6	sand	668	gas tested 8,000		
34	shale dark	702			
53	shale light	755			
5	blak shale	760			
28	shale blue	788			