FORM 51 5M 11-44 PETROL

KANSAS

Cowley County

Section 15 Township 33 Range 3E

Well No. #1 Byrd (Bird)

Company B. B. Blair

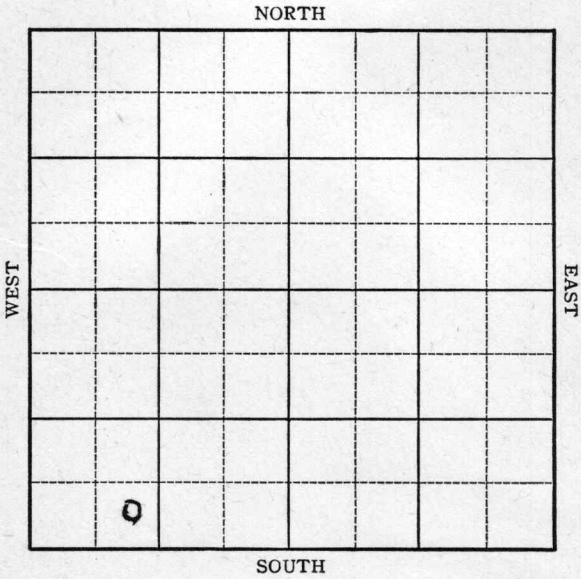

FORM 252-A
5M 6-46 PETROL

KANSAS — Cowley County ✓

Sec. 15 Twp. 33 R. 3E

Well No. #1 Byrd Farm

B. B. Blair Company

Miscellaneous

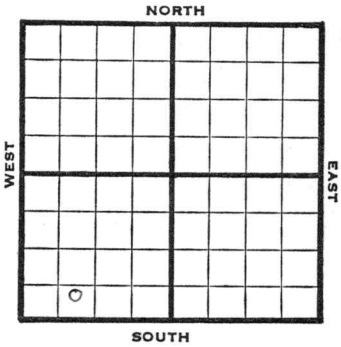

Ft. from N. Line

400 Ft. from S. Line

Ft. from E. Line

940 Ft. from W. Line

SE SW SW

1946	1136 Elev. REPORT
6/26	8" @ 100 Drlg. 1900'
7/3	KC 2770 Drlg 3048'
7/9	Bart 3236 TD 3239 5" @ 3236, RUST
7/16	Miss 3251' TD 3284 HFO
7/23	" "
7/30	" "
8/7	Bart. 3236 5" @ 3236 Miss. 3251 TD 3284 Pump 25 Pot. Grav. 39.0

COMPLETED

FORM 26 200 BKS 2-44 PETROL

Kansas Pool Name Miscellaneous

KANSAS

Map No. ____ Sec. 15 Twp. 33 R. 3E

Well No. 1 Byrd

B. B. Blair Company

FIRST REPORT Contractor

SE SW SW

SECTION PLAT

____ Ft. from N. Line

400 Ft. from S. Line

____ Ft. from E. Line

940 Ft. from W. Line

Cowley County

Location

Rig up

Drilling and Remarks:

8" @ 100'

1900'

RECORD

Cased ____ in., ____ ft.

Sand

Gas

Oil

Total Depth

PRODUCTION

1st 24 hrs. Nat.

1st 24 hrs. after shot

Gas ____ Cu. Ft.

Dry Hole

Abandoned

Date

JUN 26 1946 19

S. J. LEWIS Scout

FORM 56 200 BKS, 1-44 PETROL

KANSAS Kansas Pool Name Miscellaneous

Map No. 1 Sec. 15 Twp. 33 R. 3E

Well No. 1 Byrd

B. B. Blair Company

COMPLETED Contractor

SE SW SW

E1.1136

SECTION PLAT

6			

Ft. from N. Line

400 Ft. from S. Line

Ft. from E. Line

940 Ft. from W. Line

Cowley County

Location

Rig up

Drilling and Remarks:

Bar #3236

5" @ 3236

Miss 3251

Pump 25 Pt

39° Gr

RECORD

Cased in., ft.

Sand

Gas

Oil

Total Depth 3284

PRODUCTION

1st 24 hrs. Nat.

1st 24 hrs. after shot

Gas Cu. Ft.

Dry Hole

Abandoned

Date

AUG 7 1946 19

S. J. LEWIS Scout