
Cowley

KANSAS

15 SECTION 33 TOWNSHIP 3E RANGE

WELL NO. #2 Bird

COMPANY McNeish & Gralapp

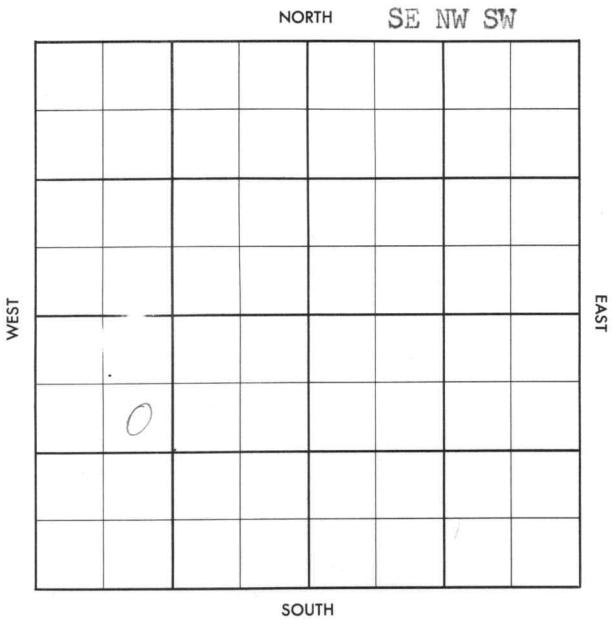

FORM 504-3 SUNRAY

FORM 513 SUNRAY

County Cowley Elev.

Sec. 15 Twp. 33 Rge. 3E

Company McNeish & Gralapp

Farm Name Bird No. 2

TOPS	DEPTH	LOG	DATUM
Anh.			
Tp.			
H.			
Tr.			
Dg.			
B.L.			
L.			
K.C.			
B.K.C.			
Ce.			
C.			
M.			
M.			
K.			
Mz.			
Mq.			
V.			
S.			
S.			
A			
R.			
P€.			
G.			
T.D.			

Loc. in Sec. SE NW SW

Geol.

Contr. Watson Tools

Pool Graham

FIRST REPORT

Date Comm. 3-15-57

8" @ 120/100, Drlg. 1750

29

Co. Lse. No. Sec. T. R.

FORM 513 SUNRAY

County Cowley Elev. 1153'

Sec. 15 Twp. 33 Rge. 3E

Company McNeish & Gralapp

Farm Name Bird No. 2

TOPS	DEPTH	LOG	DATUM
Anh.			
Tp.			
H.			
Tr.			
Dg.			
Bl.			
L.			
K.C.	2782		
B.K.C. OSW	2973		
Ce.			
C. Bartlsd	3256		
M. Chat	3258		
M.			
K.			
Mz.			
Mo.			
V.			
S.			
S.			
A			
R.			
P€.			
G.			
T.D.	3267		

Loc. in Sec. SE NW SW

Geol.

Contr. Watson Tools

Pool Graham

COMPLETE

9

APR 17 '57

Date Comm. 3-15-57

8" @ 120/100, Drlg. 1750 MAR 27 '57

5½ 3257 APR 3 '57 APR 10 '57 CO 3267

APR 17 '57 FU 200' oil 12 hrs Frac

& 5 Boph + Tr. wtr 3 hrs

Pot est 8.25 Bopd no wtr

Co. Lse. No. Sec. T. R.