


SECTION 15 TOWNSHIP 33S RANGE 3E

WELL NO. #4 Bird

COMPANY McNeish & Gralapp

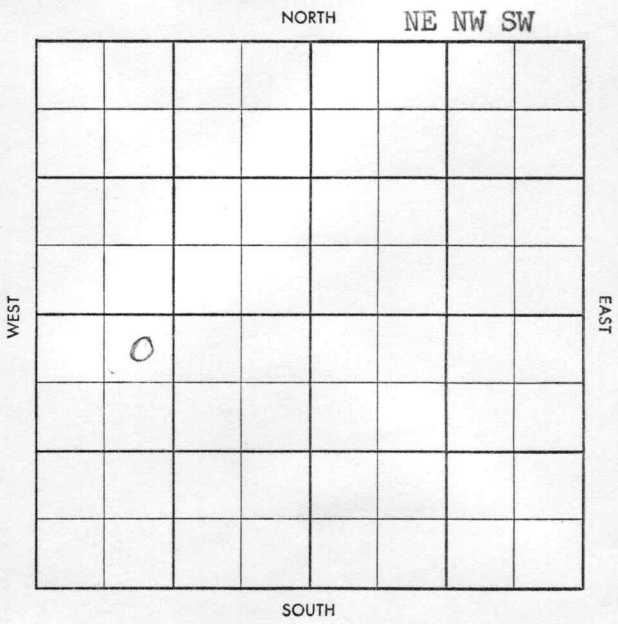

~~Pop-up Prod~~  
~~Co. Prod~~

County Cowley Elev. \_\_\_\_\_  
Sec. 15 Twp. 33 Rge. 3E  
Company McNeish & Gralapp  
Farm Name Bird No. 4

TOPS	DEPTH	LOG	DATUM
Anh.			
Tp.			
H.			
Tr.			
Dg.			
B.L.			
L.			
K.C.			
B.K.C.			
Ce.			
C.			
M.			
M.			
K.			
Mz.			
Mq.			
V.			
S.			
S.			
A.			
R.			
Pf.			
G.			
T.D.			

Loc. in Sec. NE NW SW  
Geol. \_\_\_\_\_  
Contr. \_\_\_\_\_  
Watson Drlg  
Pool Graham



Date Comm. spudding.

Co.  
Lse.  
No.  
Sec.  
T.  
R.

Twp. X Pool X  
 Co. X Facet X

S-513-B

County Cowley Elev. 1162DF 1165RB  
 Sec. 15 Twp. 33 Rge. 3E  
 Company McNeish & Gralapp  
 Farm Name Bird No. 4

TOPS	DEPTH	LOG	DATUM
Anh. <u>Stal</u>	<u>2231</u>		
Tp.			
H. <u>Loy</u>	<u>2666</u>		
Tr.			
Dg.			
B.L.			
L.			
K.C.	<u>2780</u>		
B.K.C.			
Ce. <u>OSW</u>	<u>2982</u>		
C.			
M.	<u>3268</u>		
M.			
K.			
Mz.			
Mq.			
V.			
S.			
S.			
A.			
R.			
Pf.			
G.			
T.D.	<u>3272</u>		

Loc. in Sec. NE NW SW  
 Geol. \_\_\_\_\_  
 Contr. \_\_\_\_\_  
Watson Drlg  
 Pool \_\_\_\_\_  
Graham

**ABANDONED**  
 0  
 MAY 21 '58

Date Comm. 4-27 -58 8" 140  
spudding. MAY 7 '58 82979 MAY 14 '58 MAY 21 '58

D & A

Co.  
 Lse.  
 No.  
 Sec.  
 T.  
 R.