


Cowley

KANSAS

SECTION 15 TOWNSHIP 33 RANGE 3E

WELL NO. #1 Miller

COMPANY Wrico Drlg.

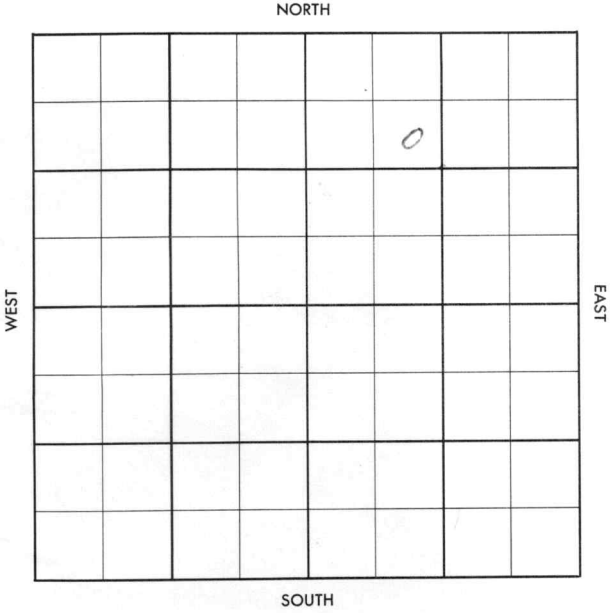

Cowley

KANSAS

SEC. 15	TWP. 33	R. 3E
------------	------------	----------

WELL NO.

#1 Miller

FARM

COMPANY

Wrico Drlg.

CONTRACTOR


_____ Ft. from N. Line

_____ Ft. from S. Line

_____ Ft. from E. Line

_____ Ft. from W. Line

SE NW NE

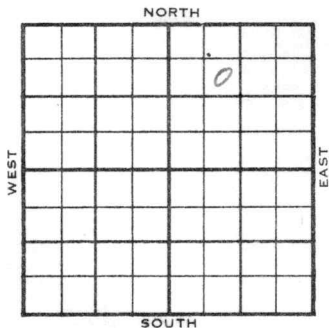

1956

ELEVATION
1169'

REPORT

5-9

Comm. 5-8-56
 ⌀ 5/8" @ 98 w/75
 WOC

7-3

5 1/2" @ 3295
 CO 36/ 3253-63
 FU 500' wtr.
 S/ 10 boph,
 Flw 5 BOPH / SSW
 P/ 25 bopd / 10 BWPD.
 Stall. 2206', Lay. 2618', KC. 2782',
 Skinner 3175', M. Chat 3253', M. Li.
 3264'.
 TD 3299'.

COMPLETED

County Cowley Elev. _____
 Sec. 15 Twp. 33 Rge. 3E
 Company Wrico Drlg.
 Farm Name Miller No. 1

TOPS	DEPTH	LOG	DATUM
Anh.			
Tp.			
H.			
Tr.			
Dg.			
Bl.			
L.			
K.C.			
B.K.C.			
Ce.			
C.			
M.			
M.			
K.			
Mz.			
Mq.			
V.			
S.			
S.			
A.			
R.			
P.			
G.			
T.D.			

Loc. in Sec. SE NW NE

Geol. _____

Contr. _____

Pool _____



Date Comm. 5-8-56
8 5/8" @ 98/75 WOC

MAY 14 1956
 R.G.

29

Co.

Lse.

No.

Sec.

T.

R.

29

County Cowley Elev. 1169
 Sec. 15 Twp. 33 Rge. 3E
 Company Wrico Drle.
 Farm Name Miller No. 1

TOPS	DEPTH	LOG	DATUM
Anh.			
Tr.			
H. <u>Stall</u>	<u>2206</u>		
Tr. <u>Lay</u>	<u>2618</u>		
Dg.			
B.L.			
L.			
K.C.	<u>2782</u>		
B.K.G. <u>Skinner</u>	<u>3175</u>		
Ce.			
C.			
M. <u>chat</u>	<u>3253</u>		
M. <u>LI</u>	<u>3264</u>		
K.			
Mz.			
Mo.			
V.			
S.			
S.			
A.			
R.			
Pe.			
G.			
T.D.	<u>3299</u>		

Loc. in Sec. SE NW NE

Geol.

Contr.

Pool

COMPLETE

Date Comm. 5-8-56 JUL 3 1956

8 5/8" @ 98/75 WOC MAY 16 '56 2792

MAY 23 '56 5 1/2 @ 3295/ MAY 29 '56 JUN 6 '56

JUN 13 '56 C.O. JUN 20 '56 CO 36/3253-63

FU 500' wtc (GSO) To Frac JUN 27 '56

\$ 10 Boph POP JUL 3 '56

Flw 5 Boph + 55 W P. 25

Bopd + 10 Bwpd.

Co.
Lse.
No.
Sec.
T.
R.