

Cowley


KANSAS

SECTION 15 TOWNSHIP 33 RANGE 3E

WELL NO. #2 Miller

COMPANY Crest Petroleum

NORTH

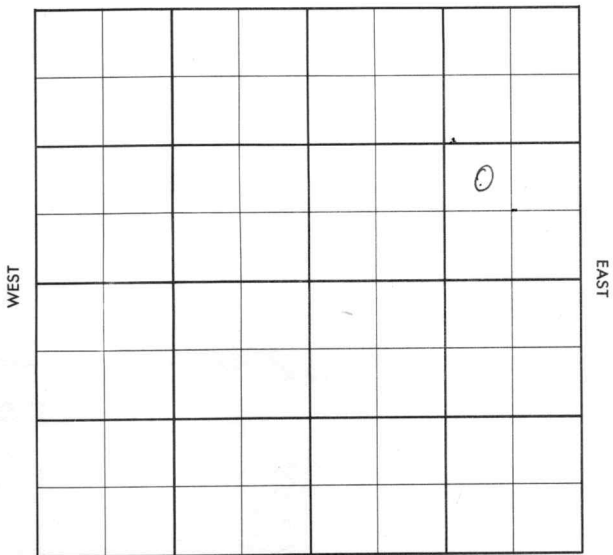

SOUTH

County Cowley Elev. _____
 Sec. 15 Twp. 33 Rge. 3E
 Company Crest Petroleum
 Farm Name Miller No. 2

TOPS	DEPTH	LOG	DATUM	Loc. in Sec.
Anh.				NW SE NE
Tp.				
H.				
Tr.				
Dg.				
Bl.				
L.				Geol. _____
K.C.				Contr. _____
B.K.C.				
Ce.				
C.				Wrico Tools
M.				
M.				Pool
K.				
Mz.				Rainbow Bend
Me.				NE
V.				SEP 19 '56
S.				0
S.				
A.				
R.				
PE.				
G.				FIRST REPORT
T.D.				

Date Comm. 9-13-56

8" @ 100, Drlg. 1900 SEP 26 '56

SEP 5 7 1956

219

2.8

Co.
Lse.
No.
Sec.
T.
R.

County Cowley Elev. 1169
 Sec. 15 Twp. 33 Rge. 3E
 Company Crest Petroleum
 Farm Name Miller No. 2

TOPS	DEPTH	LOG	DATUM
Anh.			
Tp.			
H.			
Tr.			
Dg.			
Bl.			
L.			
K.C.			
B.K.C.			
Ce.			
C.			
M.	3271		
M.			
K.			
Mz.			
Ma.			
V.			
S.			
A.			
R.			
PE.			
G.			
TD.	3340		

Loc. in Sec. NW SE NE
 Geol. _____
 Contr. Wrico Tools
 Pool Rainbow Bend
 NE
 OCT 31 56
 COMPLETE

Date Comm. 9-13-56

8" @ 100, Drlg. 1900 SEP 26 56 5 1/2 e

3340 OCT 3 56 WACT OCT 10 56 24/

3280-84 25/3285-89 1/2
 OCT 17 56 FRAC OCT 24 56 FLOW 20

Boph OCT 31 56 Flw 300 Bopd
no/wtr