

Cowley

KANSAS

SECTION 15 TOWNSHIP 33 RANGE 3 E

WELL NO. # 1 Bird

COMPANY Hartman

NORTH

WEST								EAST

SOUTH

0

Cowley

KANSAS

SEC. 15	TWP. 33	R. 3E
------------	------------	----------

WELL NO.

#1 Bird

FARM

COMPANY

~~#####~~ Hartman

CONTRACTOR

Co. Tools

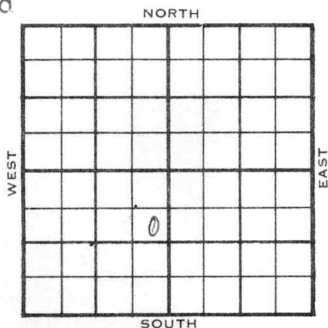
Rainbow Bend

_____ Ft. from N. Line

_____ Ft. from S. Line

_____ Ft. from E. Line

_____ Ft. from W. Line

~~###~~ SE NE SW

1956

ELEVATION

1157'

REPORT

4-25 RUR

7-3

Comm. 4-24-56

8 5/8" @ 95 w/80

5 1/2" @ 3292 w/50

P/ 15 B0 / wtr., 24 hrs.

28/3267-74, frac,

P/ 25 BOPD / wtr.

Log tops:

Stall. 2209', Lay. 2618', KC. 2779',

Bartls 3n. 3236', M. Chat 3260'.

TD 3292'.

COMPLETED

County Cowley Elev. _____
Sec. 15 Twp. 33 Rge. 3E
Company Hartman
FarmName Bird No. 1

TOPS	DEPTH	LOG	DATUM	Loc. in Sec.
Anh.				SE NE SW
Tp.				
H.				
Tr.				
Dg.				
BL.				
L.				Geol. _____
K.C.				Contr. _____
B.K.C.				Co. tools
Ce.				Pool
C.				Rainbow Bend
M.				
M.				
K.				
Mz.				
Me.				
V.				
S.				
S.				
A.				
R.				
Pe.				
G.				
T.D.				

FIRST REPORT
APR 25 '58

Date Comm. RUR

29

MAY 5 1958

R.R. Co.

29

County Cowley Elev. 1157
 Sec. 15 Twp. 33 Rge. 3E
 Company Hartman
 Farm Name Bird No. 1

TOPS	DEPTH	LOG	DATUM	Loc. in Sec.
Anh. <u>Stall</u>		<u>2209</u>		<u>SE NE SW</u>
Top <u>Loay</u>		<u>2618</u>		
H.				
Tr.				
Dg.				
BL.				
L.				Geol.
K.C.		<u>2779</u>		
B.K.C. <u>Bartlen</u>		<u>2236</u>		Contr.
Ce.				<u>Co. tools</u>
C.				
M. <u>chat</u>		<u>3260</u>		Pool
M.				<u>Rainbow Bend</u>
K.				
Mz.				
Me.				
V.				
S.				
S.				
A.				
R.				
Pe.				
G.				
T.D.	<u>3292</u>			

COMPLETE

Date Comm. JUL 3 1956

RUR MAY 2 '56 4-24-56 85/8 95/80

ID 2820 MAY 9 '56 5 1/2 @ 3292/50

MAY 16 '56 MICT MAY 23 '56 MAY 29 '56 MICT

JUN 6 '56 an Pump - No logs JUN 13 '56 -

JUN 20 '56 P. 15 BO + wtr 24 hrs

JUN 27 '56 JUN 3 '56 28/3267-74 FRAC

P. 25 Bopd + wtr.