

Section 15 Township 33 Range 3E

Well No. #1 Miller

Company F. G. Hall & Drillers & Producers

NORTH

				0			

WEST

EAST

SOUTH

Cowley

KANSAS ✓

Sec. 15 Twp. 33 R. 3E

Well No. #1 Miller Farm

F.G. Hall & Drillers & Producers Company

Capitt - Contr. Contractor


Graham

330' Ft. from N. Line

_____ Ft. from S. Line

_____ Ft. from E. Line

330' Ft. from W. Line

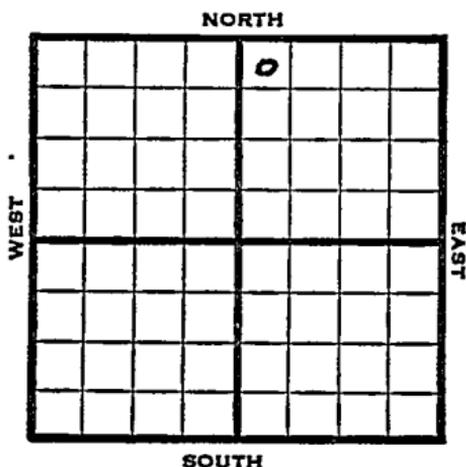

NW NW NE

1952

Elev. 1163' REPORT

6/25

Surf Set

7/23

Spud 7-25-52

D&A TD 3291' 8" @ 100

Layton 2601 KC 2766

Bart. 3214 Miss. 3236

TD 3291' D&A

ABANDONED


County **Cowley** State **Kansas**

Sec. **15** (Blk. Twp.) **33** (Sur. Rge.) **3E** Map No.

Operator **F. G. Hall & Drillers & Producers**

Well No. **1** Farm **Miller**

Elev. _____ Location **NW NW NE**

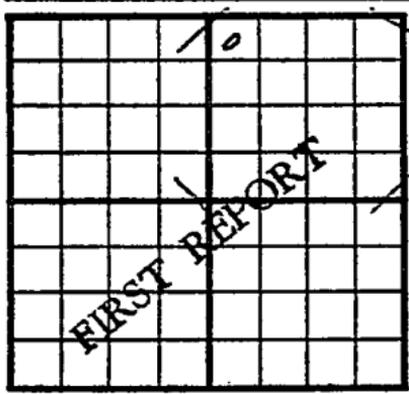

330 Ft. From **N** Line **NE**

330 Ft. From **W** Line **Quarter**

1st. Report. **JUN 25 1952**

Completion _____

Remarks _____

Capitt - Contr.

Spudding Date _____

Drig. Data **Graham**

Surf set

J. G. McGEHEE

County Cowley State Kansas
 Sec. 15 (Blk.) 33 (Sur. Rge.) 3E Map No. _____
 Operator F. G. Hall & Drillers & Producers
 Well No. 1 Farm Miller
 Elev. 1163 Location NW NW NE

		0		

330 Ft. From N Line NE
 330 Ft. From W Line Quarter

Ist. Report _____
 Completion JUL 23 1952
 Remarks Graham Pool
Capitt - Contr.
 Spudding Date 7-2-52

Drlg. Data D & A TD 3291
8" @ 100 Layton 2601 KC 2766
Bart. 3214 Miss. 3236 TD 3291

D & A