


Section 19 Township 13 Range 14-W

Well No. #1-J Deines

Company Texas

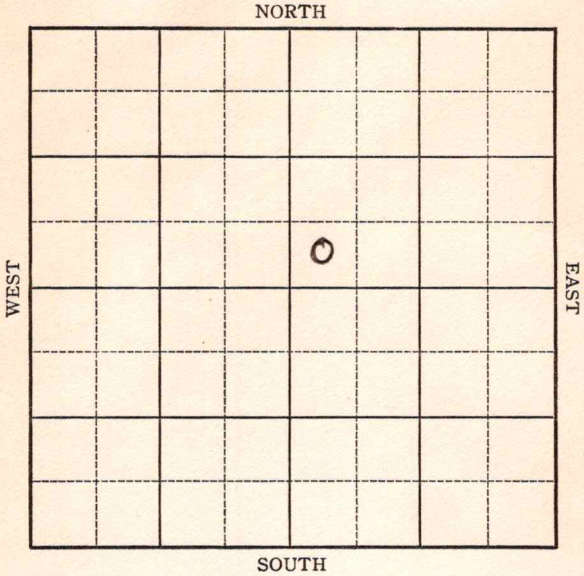

1937

10/13 5" @ 3251'.

Sil. 3251'.

T.D. 3261'.

1000 acid.

2000 acid.

Pump 219 bbls. 4 hrs & 212 bbls. 4 hrs.

Potential 1276 bbls.

COMPLETED

Russell KANSAS

Map No. 72 Sec. 19 Twp. 13 R. 14 WWell No. 1-J. Deines
Texas Company

Contractor

FIRST REPORT

SECTION PLAT

		0	

 Ft. from N. Line330 Ft. from S. Line Ft. from E. Line330 Ft. from W. LineLocation Rig up

Drilling and Remarks:

B.R.

RECORD

Cased in., ft.Sand Gas Oil Total Depth

PRODUCTION

1st 24 hrs. Nat. 1st 24 hrs. after shot Gas Cu. Ft.Dry Hole Abandoned

Date

AUG 11 1937 19H. D. Hatfield Scout

Map No. 72 Sec. 19 Twp. 13 R. 14WWell No. 1 J DeinesTexas

Company _____

Contractor _____

COMPLETED

SW NE

____ Ft. from N. Line

330 Ft. from S. Line

____ Ft. from E. Line

330 Ft. from W. Line

SECTION PLAT

		0	

Location _____

Rig up _____

Drilling and Remarks:

1000 Acid2000 AcidP-219/4 & 212/4POT-1276

RECORD

Cased 5 in., 3251 ft.Sand sil 3251

Gas _____

Oil _____

Total Depth 3261

PRODUCTION

1st 24 hrs. Nat. _____

1st 24 hrs. after shot _____

Gas _____ Cu. Ft.

Dry Hole _____

Abandoned _____

Date

OCT 13 1937 19H. D. Hatfield

Scout